


Ltr to Greenock  
 3 Oct 1887  
 3/10/87

Pipe Arrangement of S.S. No 116.  
 Scale 1/2 inch = one foot

ROBERT STEELE & Co.,  
 Shipbuilders & Engineers,  
 GREENOCK.

S.S. "Cape Clear"  
 Greenock Report No. 8090

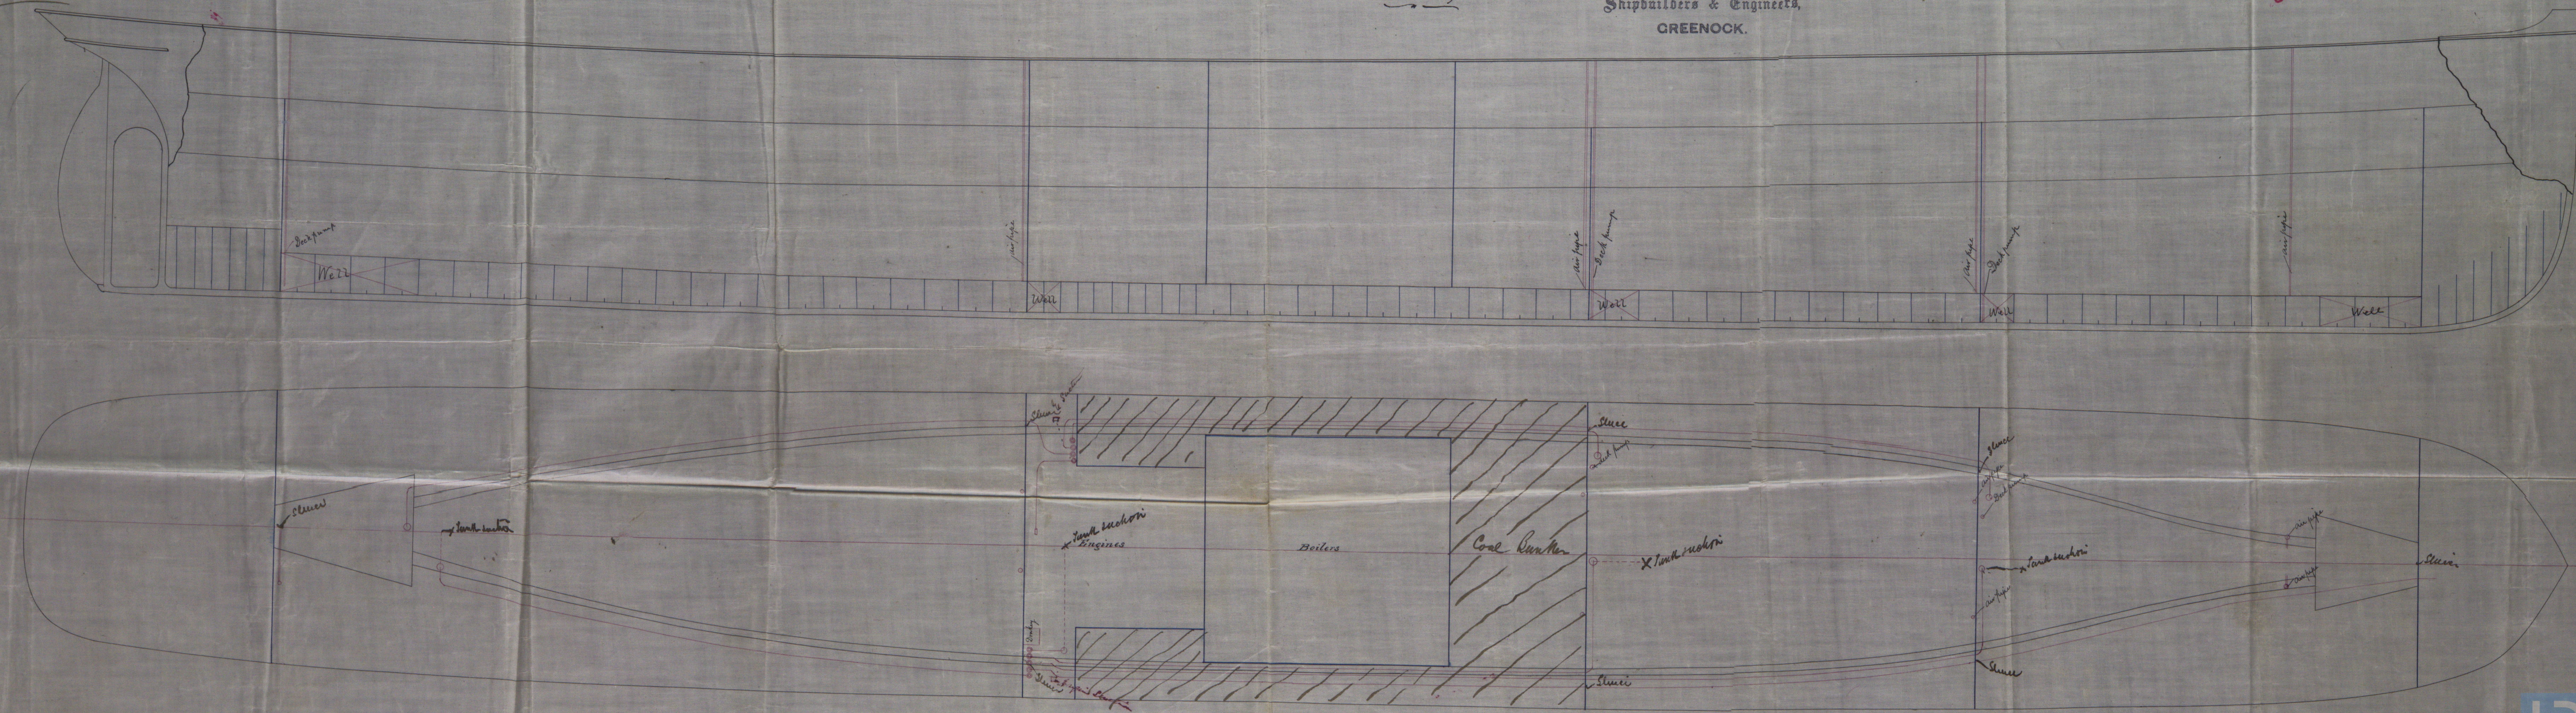



ROBERT STELL  
Shipwrights & Joiners  
GREENOCK



© 2019

Lloyd's Register  
Foundation

GRK297 - 0068