

LLOYD'S REGISTER
 SEP 24 1890
 GREENOCK


S.S. "Cape Clear"
 Greenock Report No 8090

S.S. "Cape Clear"
 Greenock Report No 8090

S.S. "Cape Clear"
 Greenock Report No 8090

S.S. No 116
 Scale 1/8" = 1 Foot

ROBERT STEELE & CO.,
 Shipbuilders & Engineers,
 GREENOCK.

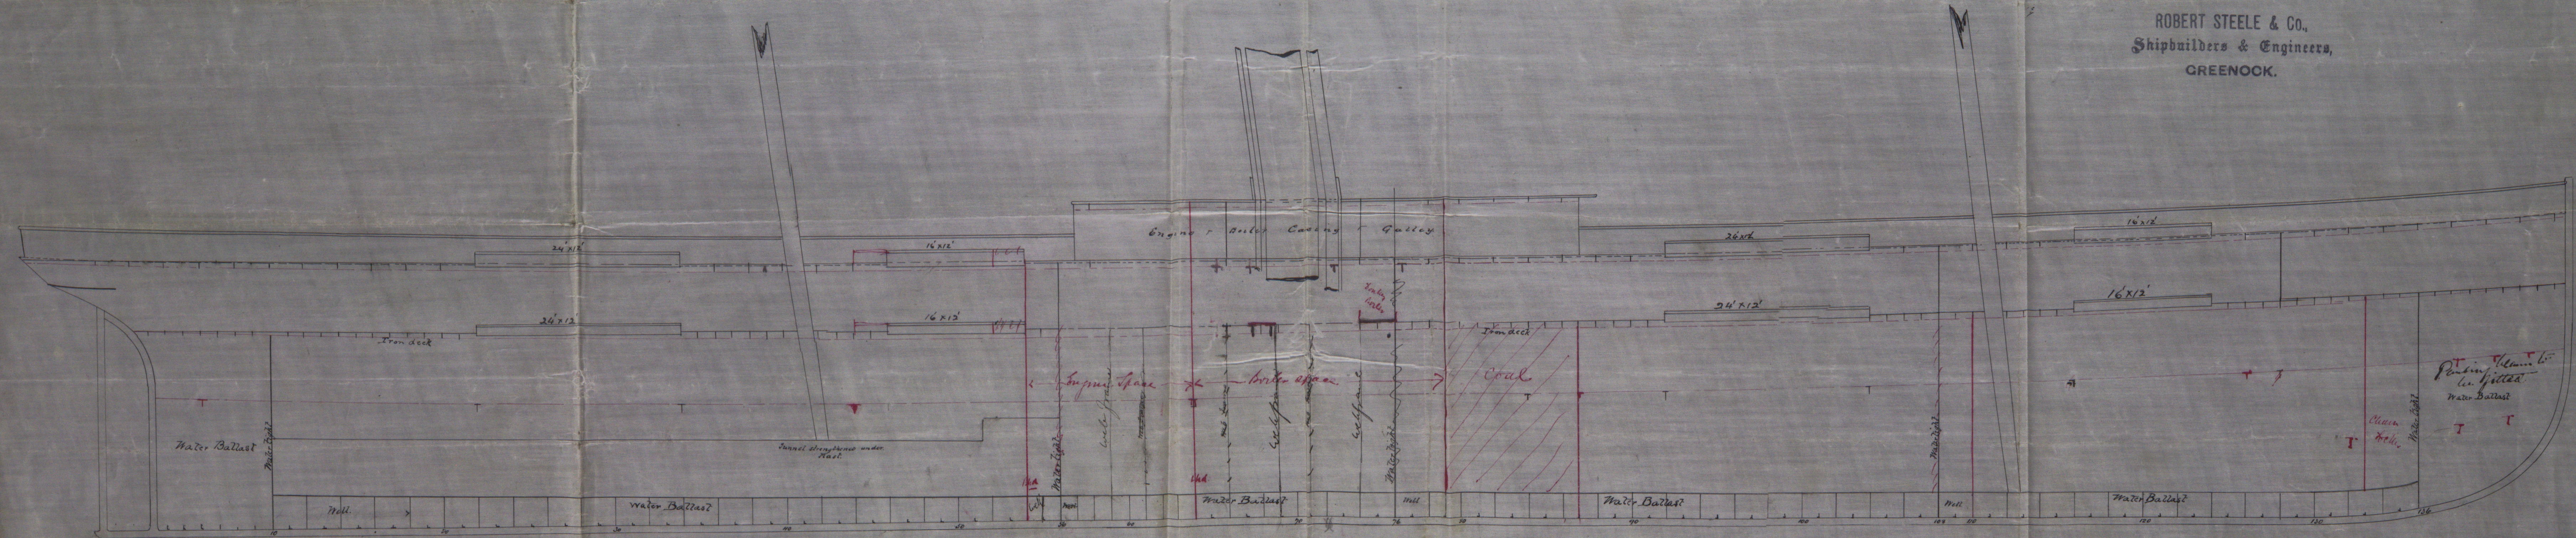


S.S. "Cape Clear"
Greenock Report No 809

S.S. No 116.

Scale $\frac{1}{8}'' = 1 \text{ Foot}$.

ROBERT STEELE & CO.,
Shipbuilders & Engineers,
GREENOCK.

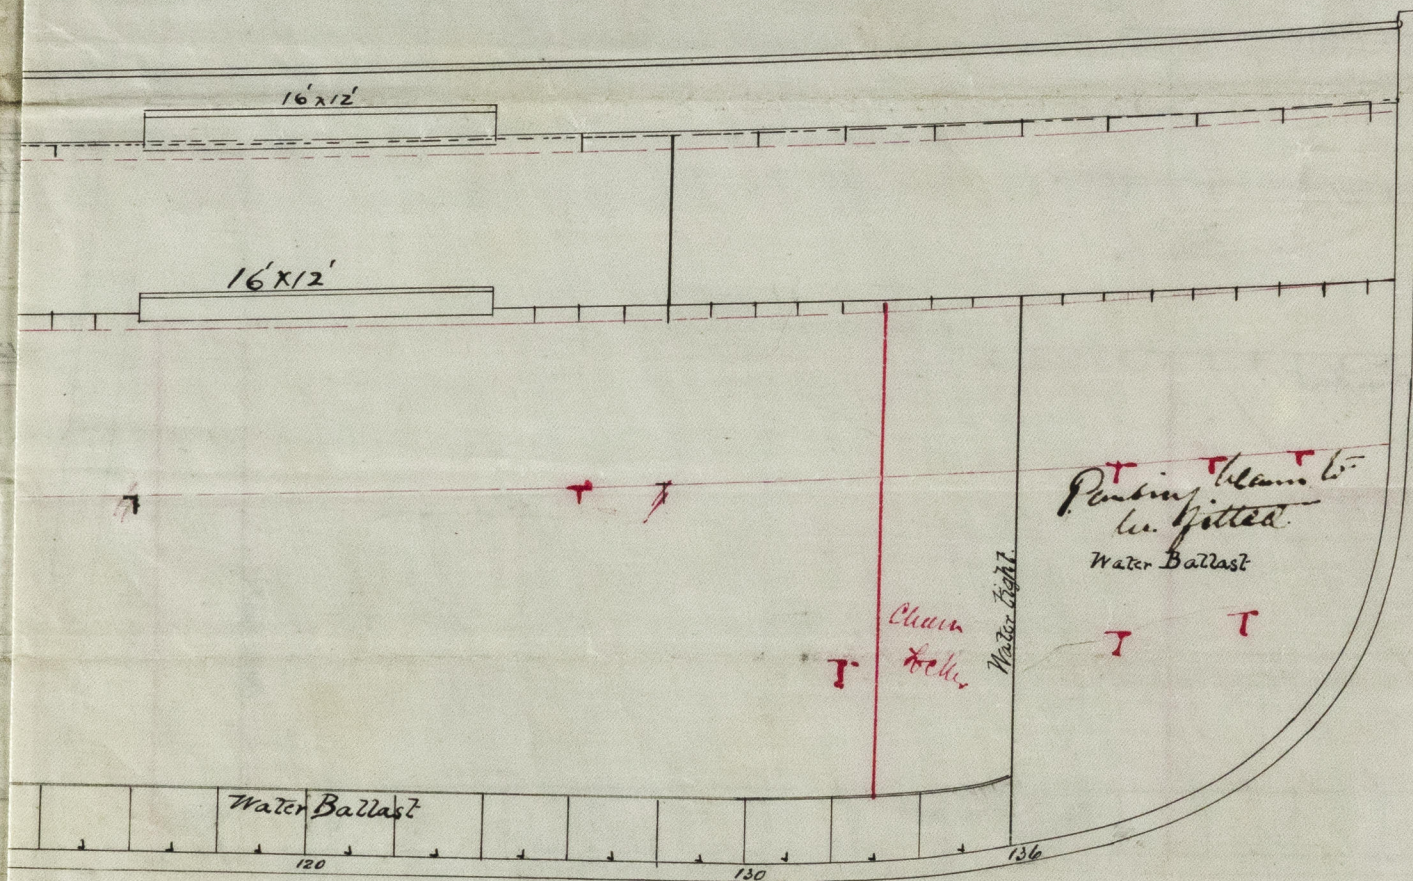

© 2019

Lloyd's Register
Foundation