

LLOYD'S REGISTER  
15 SEP 87  
LONDON


LLOYD'S REGISTER  
15 SEP 87  
LONDON

ROBERT STEELE & Co.,  
Shipbuilders & Engineers,  
GREENOCK.

Section of Ballast tank  
of  
Cape Clear  
Scale  $\frac{1}{2}$  inch = one foot  
No. 116

A

s.s. "Cape Clear"  
Greenock Report No. 8090

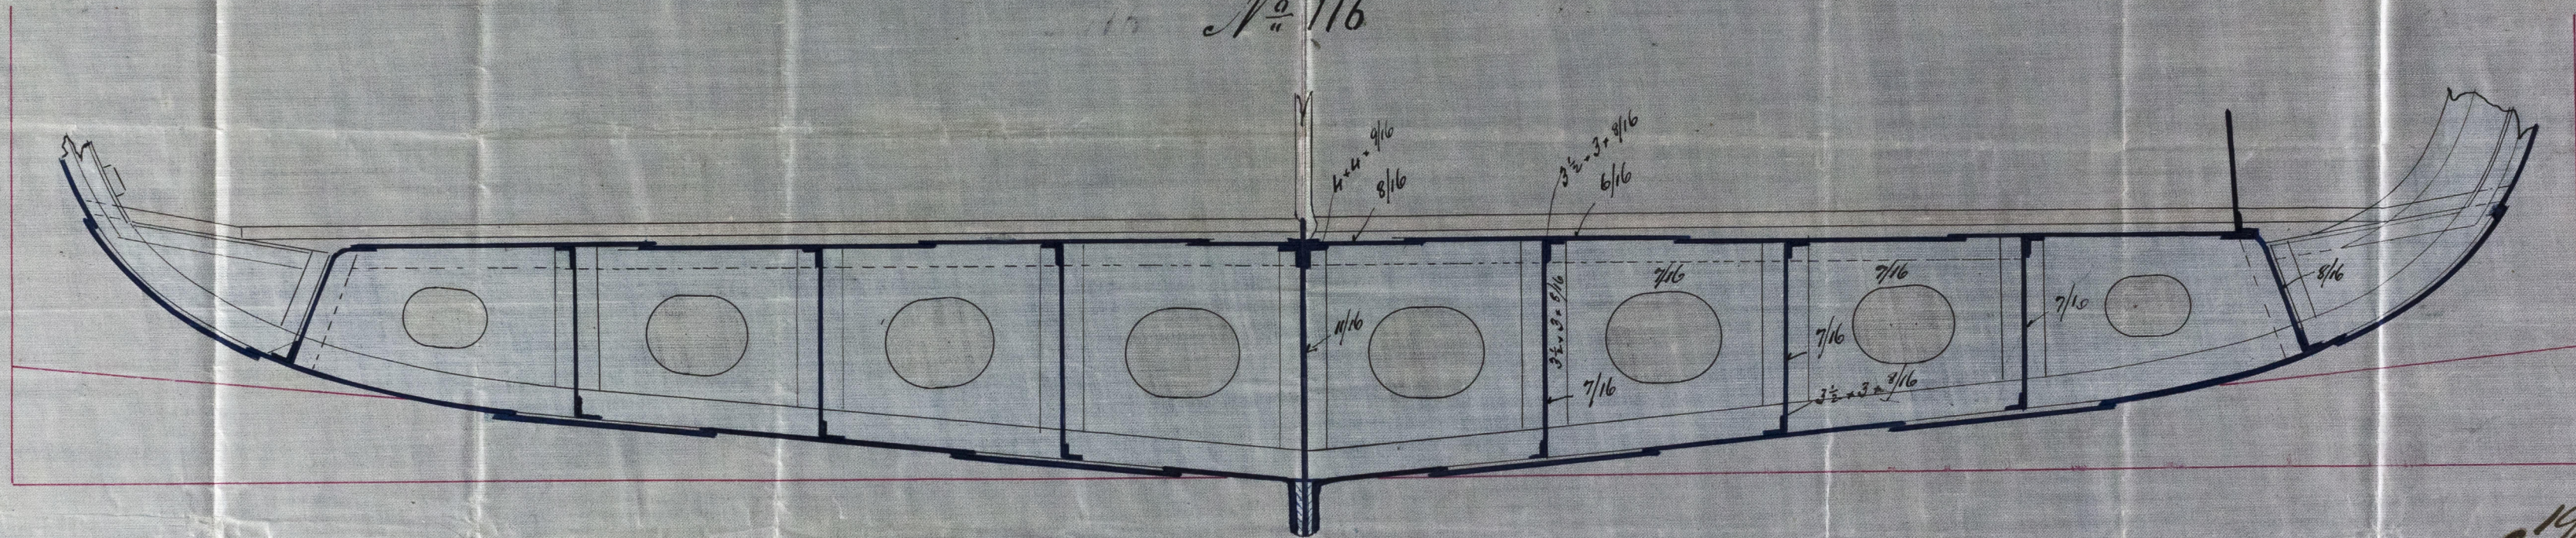

19/11/87.  
J. Dawkins



© 2019

Lloyd's Register  
Foundation