

21. 2. 81

Greenock Report No. 8/03. —
S.S. "Tolani"

Johns


MIDSHIP SECTION.

S. S. N^o 57.

Scale $\frac{1}{2}$ Inch = 1 Foot.

Class 100 A1. 3 Deck rule

Length fore edge of Stem Post. to Aft Edge of Stem.	263.58.		
Depth from top of Keel to top of Upper Deck Beam.	24.25.	- - -	24.25 ✓
$\frac{1}{2}$ Breadth.	16.958.	- - -	16.958 ✓
Half Girth.	36.6	- - -	36.6
First Numeral. 70.8. Second Numeral. 18,682.			771808 ✓
Equipment Numeral. 20,506.5			70.8
Proportions. Breadth to Length.	7.79.		263.58
" Depth to Length.	10.87. to upper deck		5664
	and 15.5 — main —		3540
			2124
			4248
			1416
			18861.464
			2.20. ✓

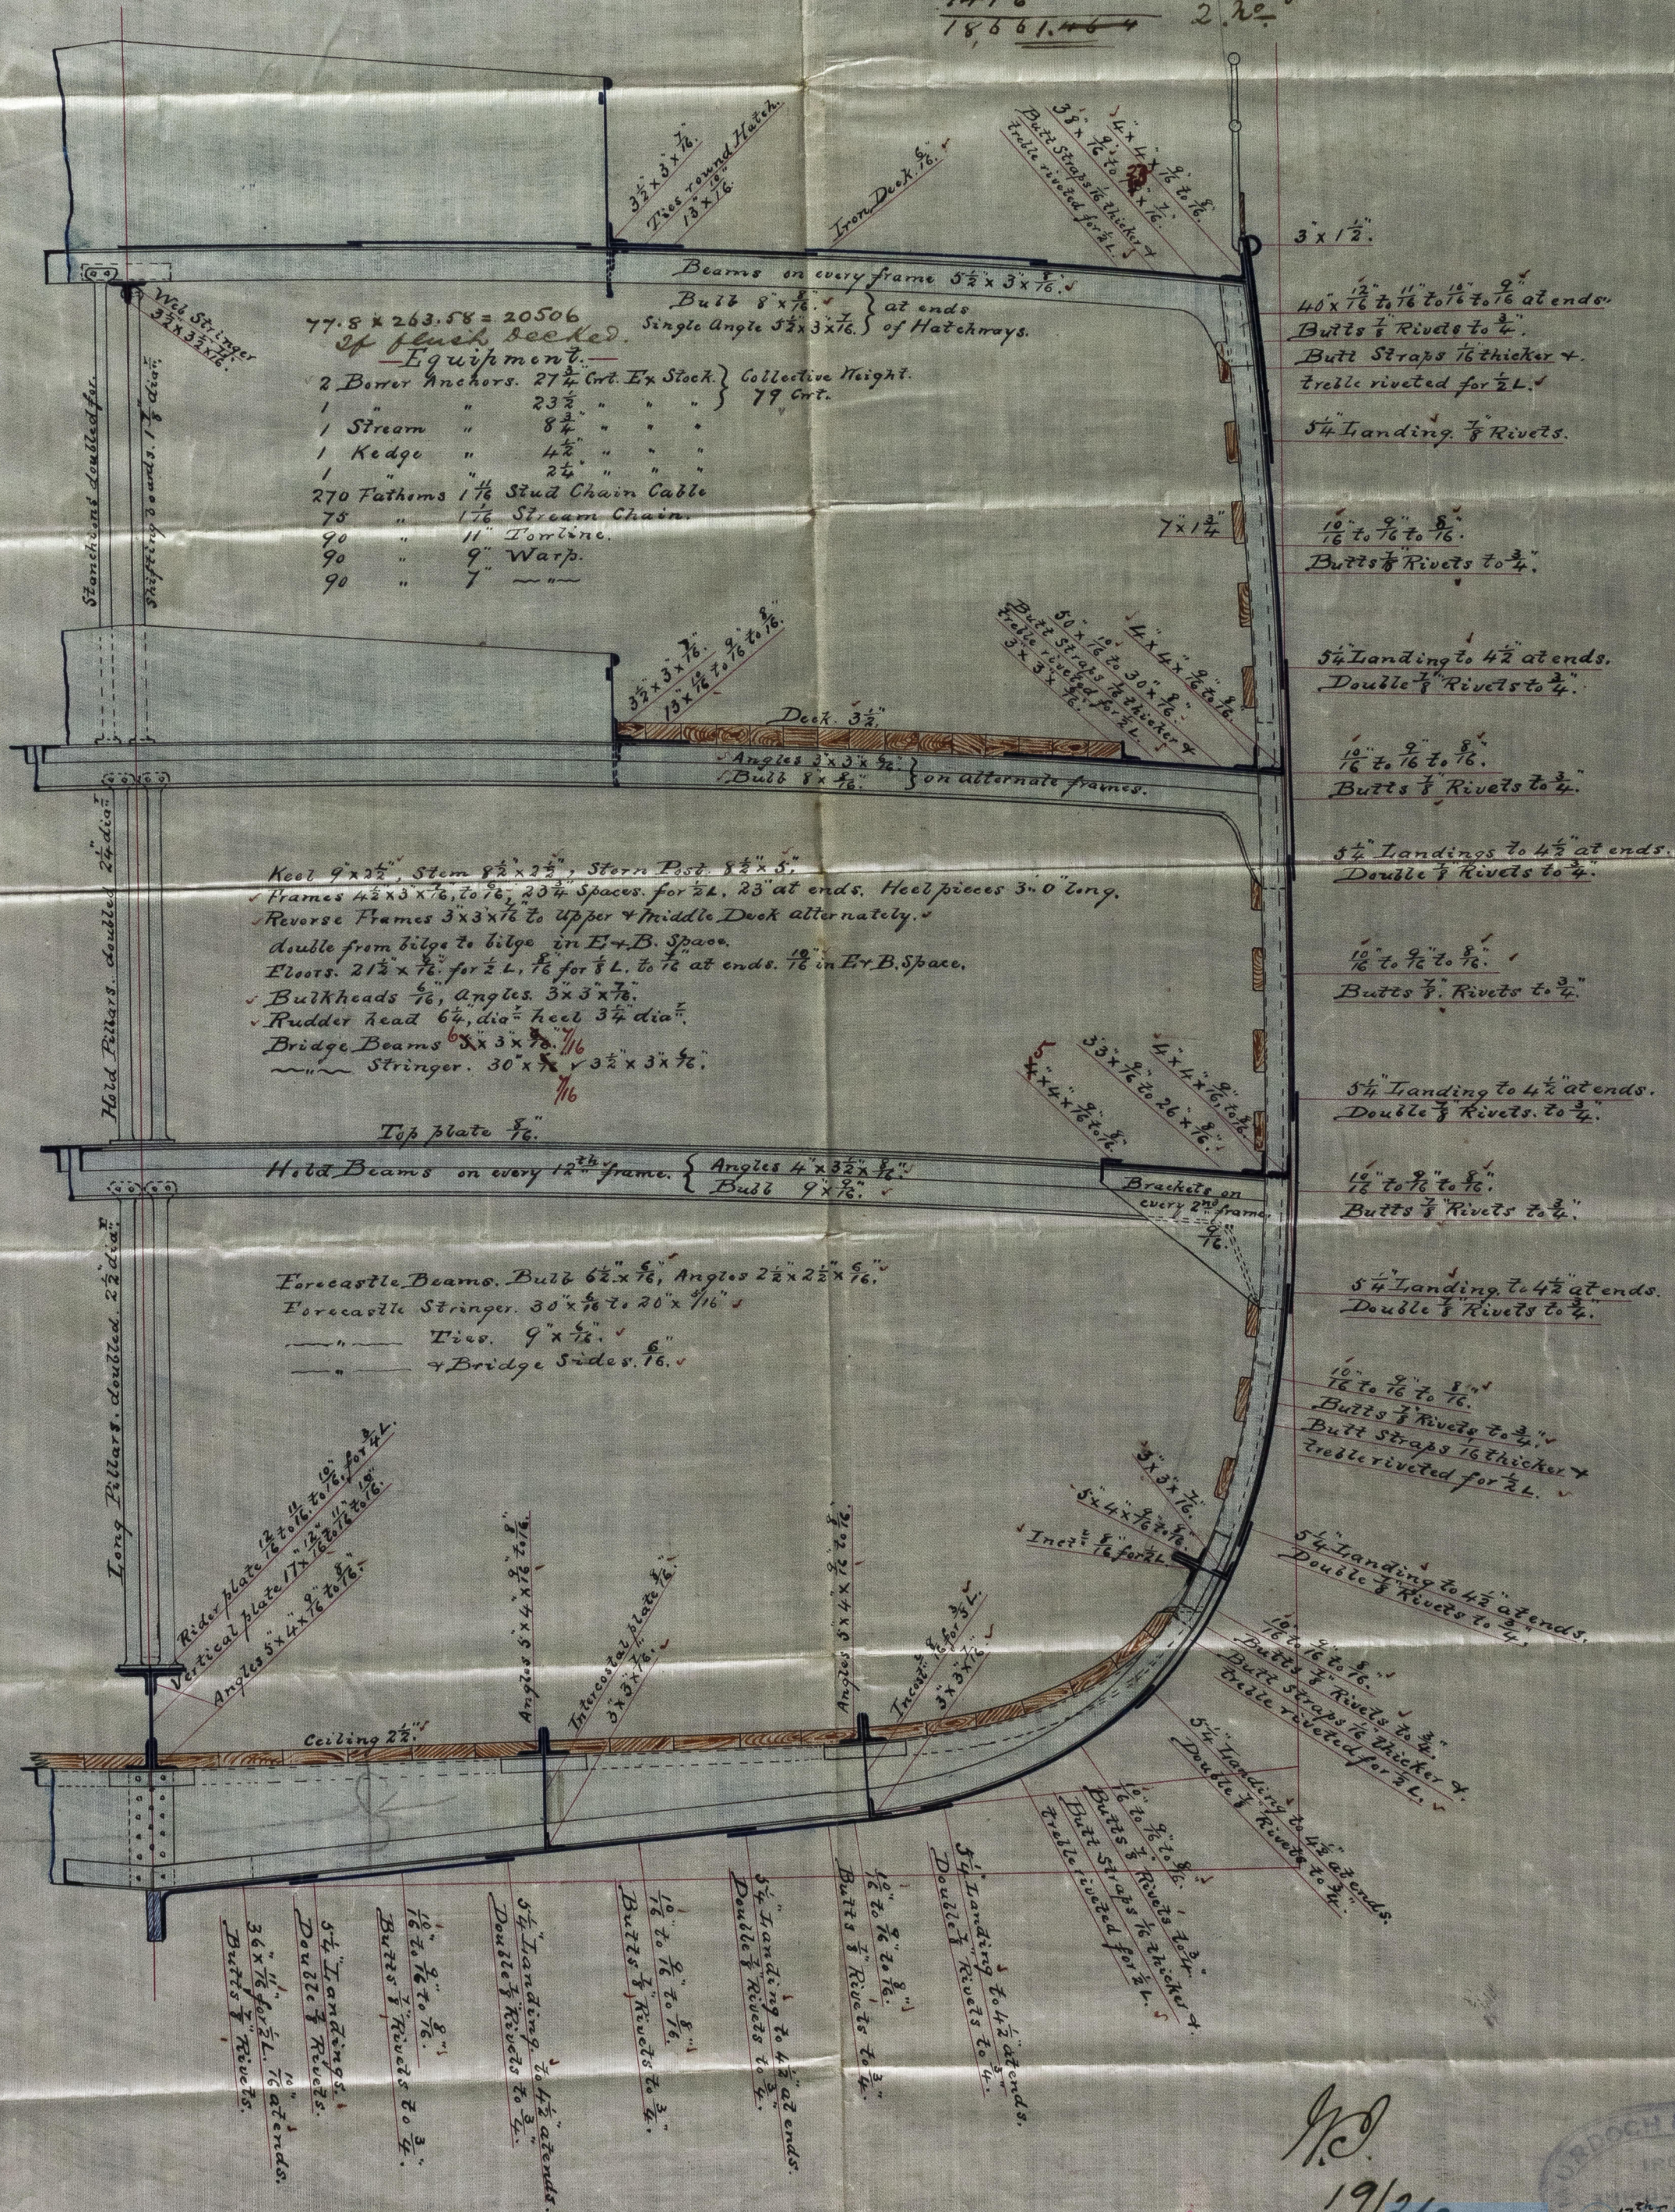

H. C. D.

19/2/81

