



MURDOCH & MURRAY  
IRON  
SHIPBUILDERS  
12th March 1881  
PORT-GLASGOW

Longitudinal Section S.S. No 57.  
Scale  $\frac{1}{4}$  Inch = 1 Foot.

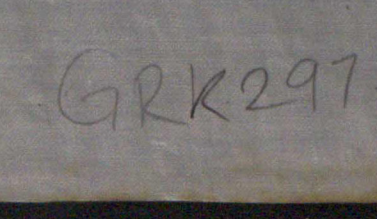

GRK297

GRK 297-0111

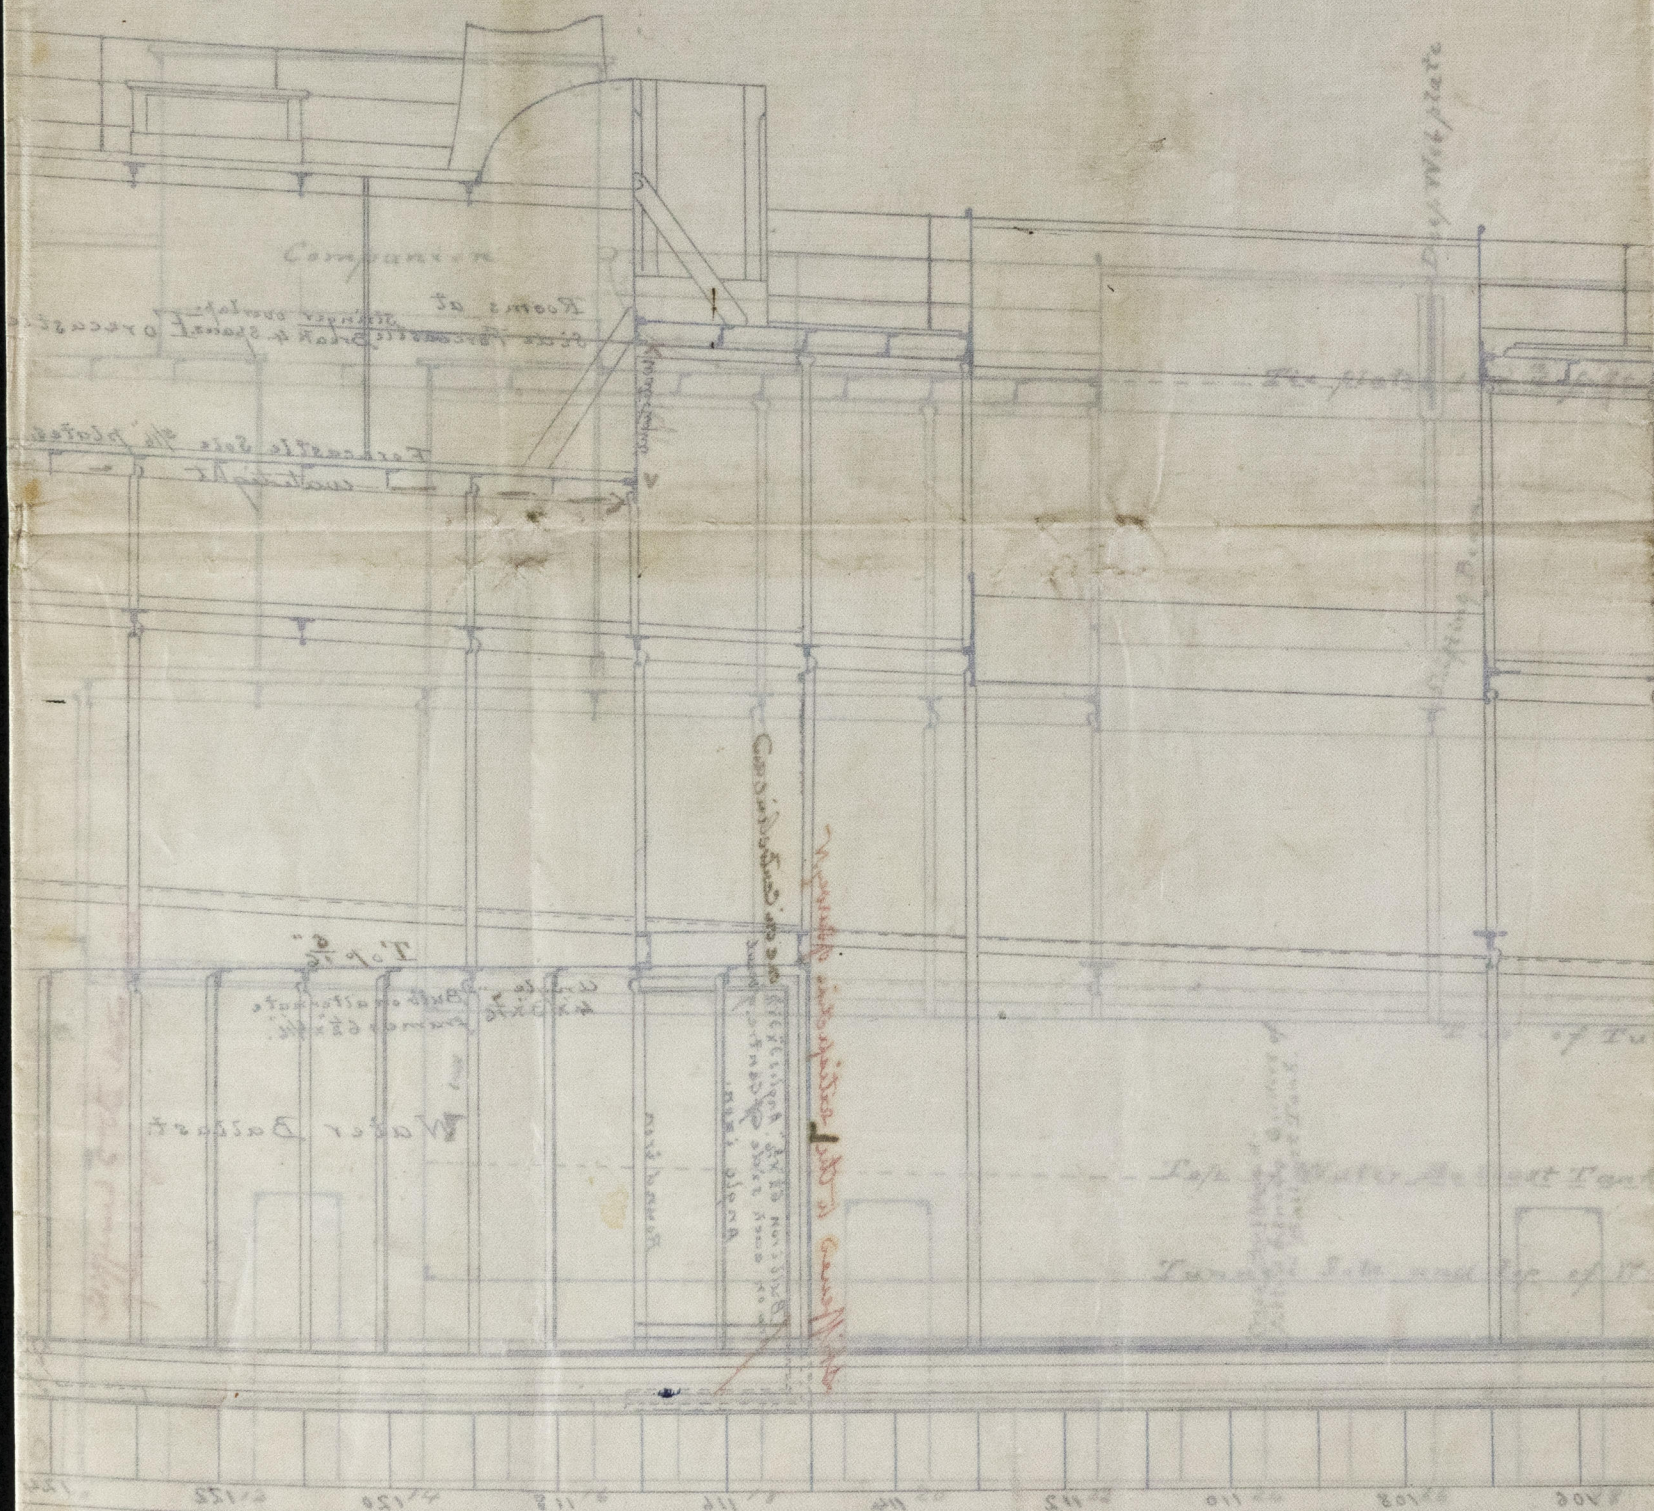

Lloyd's Register  
Foundation

GRK297-0111