

S.S. "Zuirain" Grunoch Report N° 8765

Midship Section for Screw Steamer 10° 1/2.
 Length keel & fore-rake 219' 10"
 Breadth 31' 0"
 Depth 19' 10"
 Gross tonnage about 980 tons.
 To be built to Class 90 A1 at Lloyd's.

16. 4. 81


Butt straps of main stringer plate
 sheer strake and three strakes of
 Bilge Plating, to be 1/2" thicker than
 plates and rivets, covered for half
 length amidships.

Half Boom	=	15' 5"
" " Girth	=	34' 41"
Depth to keel	=	21' 8"
First number	=	41.79
Length on deck	=	218.5
Second number	=	15686
Out fit number	=	17254

— altered as stated on Report.
 J.E.

10 depths.
 7 Beams.

Butts and edges of inner bottom
 and longitudinal girders to be
 single riveted throughout.

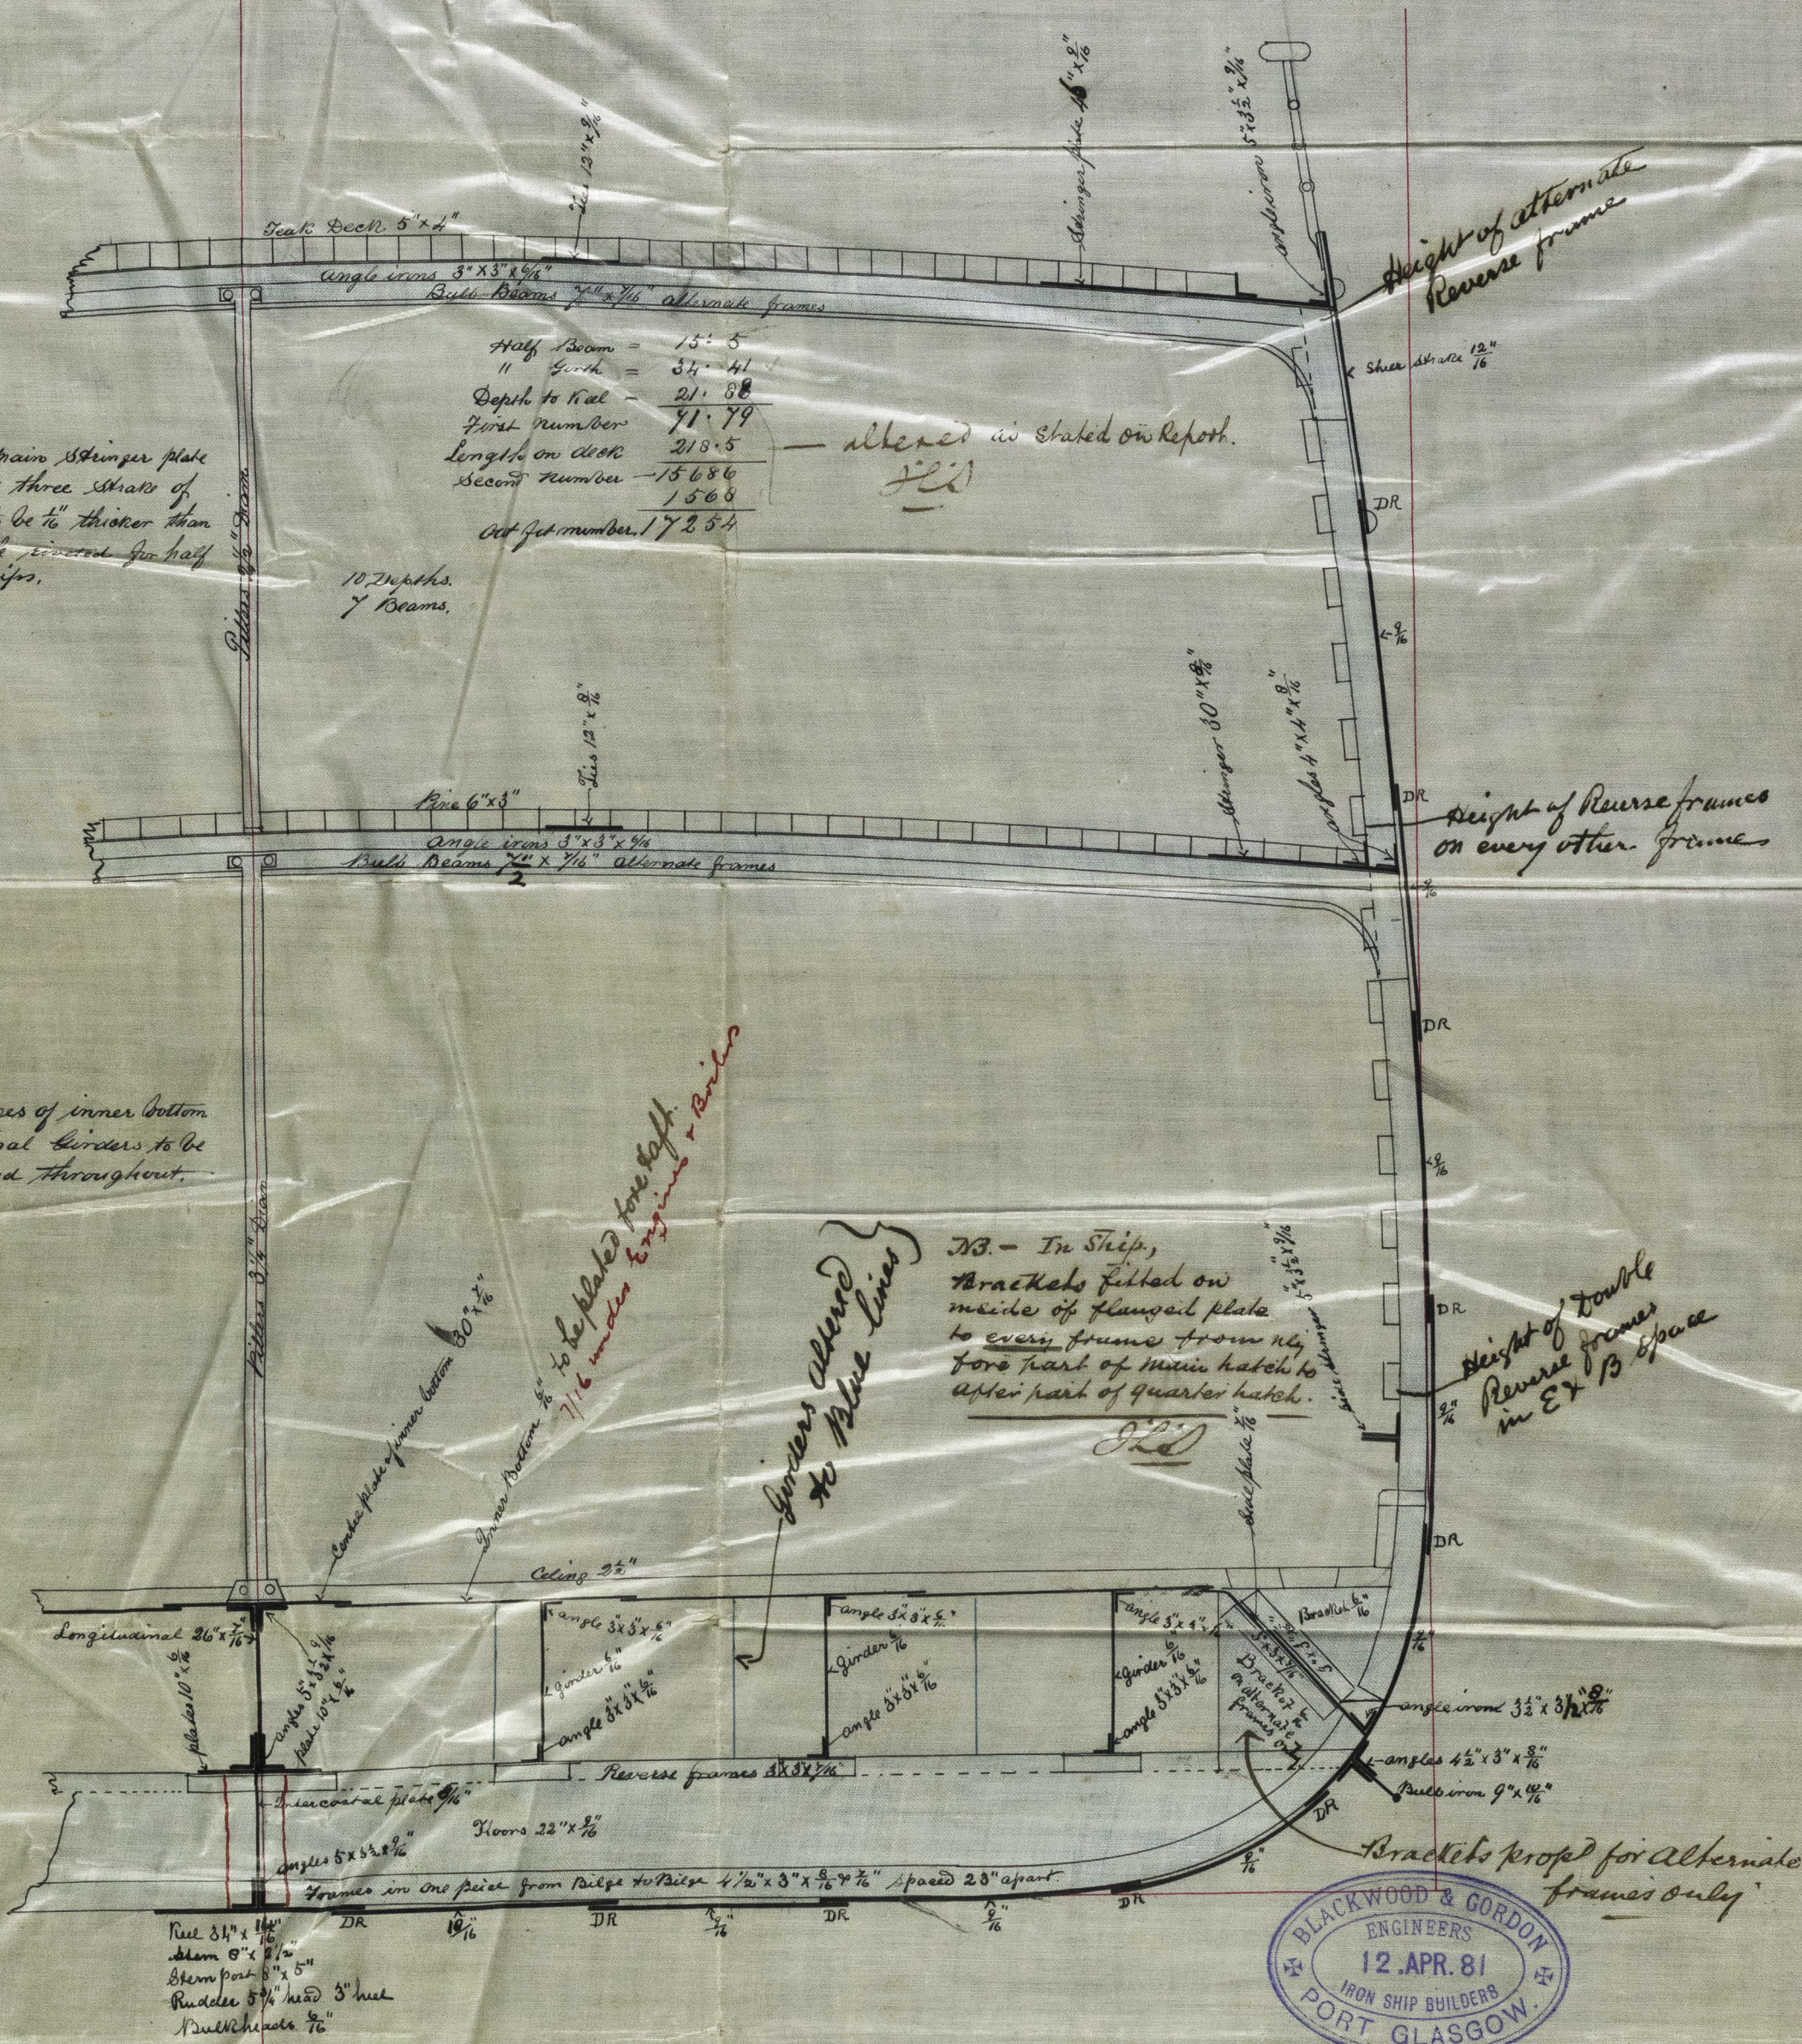

NB. — In Ship,
 Brackets fitted on
 inside of flange plate
 to every frame from 11/16
 fore part of main hatch to
 after part of quarter hatch.

Height of Double
 Reverse frames
 in Ex B space

BLACKWOOD & GORDON
 ENGINEERS
 12. APR. 81
 IRON SHIP BUILDERS
 PORT GLASGOW.

16/4/81

© 2021
 Lloyd's Register
 Foundation

GRK 298-0039