


1/2 Mudship Section. Ship No 36  
255.0 x 40.0 x 23.9  
Scale 1/2 in = 1 foot

6.3. Brotho.  
9.4. Dpths. }

Half Birth 42.0  
Half Birth 19.95  
Depth 26.65  
1<sup>st</sup> No. 88.6  
Length 252.5  
2<sup>nd</sup> No 22371.5  

Equipment	amt	
1 Bow or Stork	28	} =
1 " "	3 1/4	
1 " "	33	
1 Stream	1 1/2	✓
1 Kedge	5 3/4	✓
1 " "	2 3/4	✓
240 Fathoms 2" Steel Chain		✓
45 " 1 1/6 Stream		✓

Total weight = 10 8 1/4 Cwts.

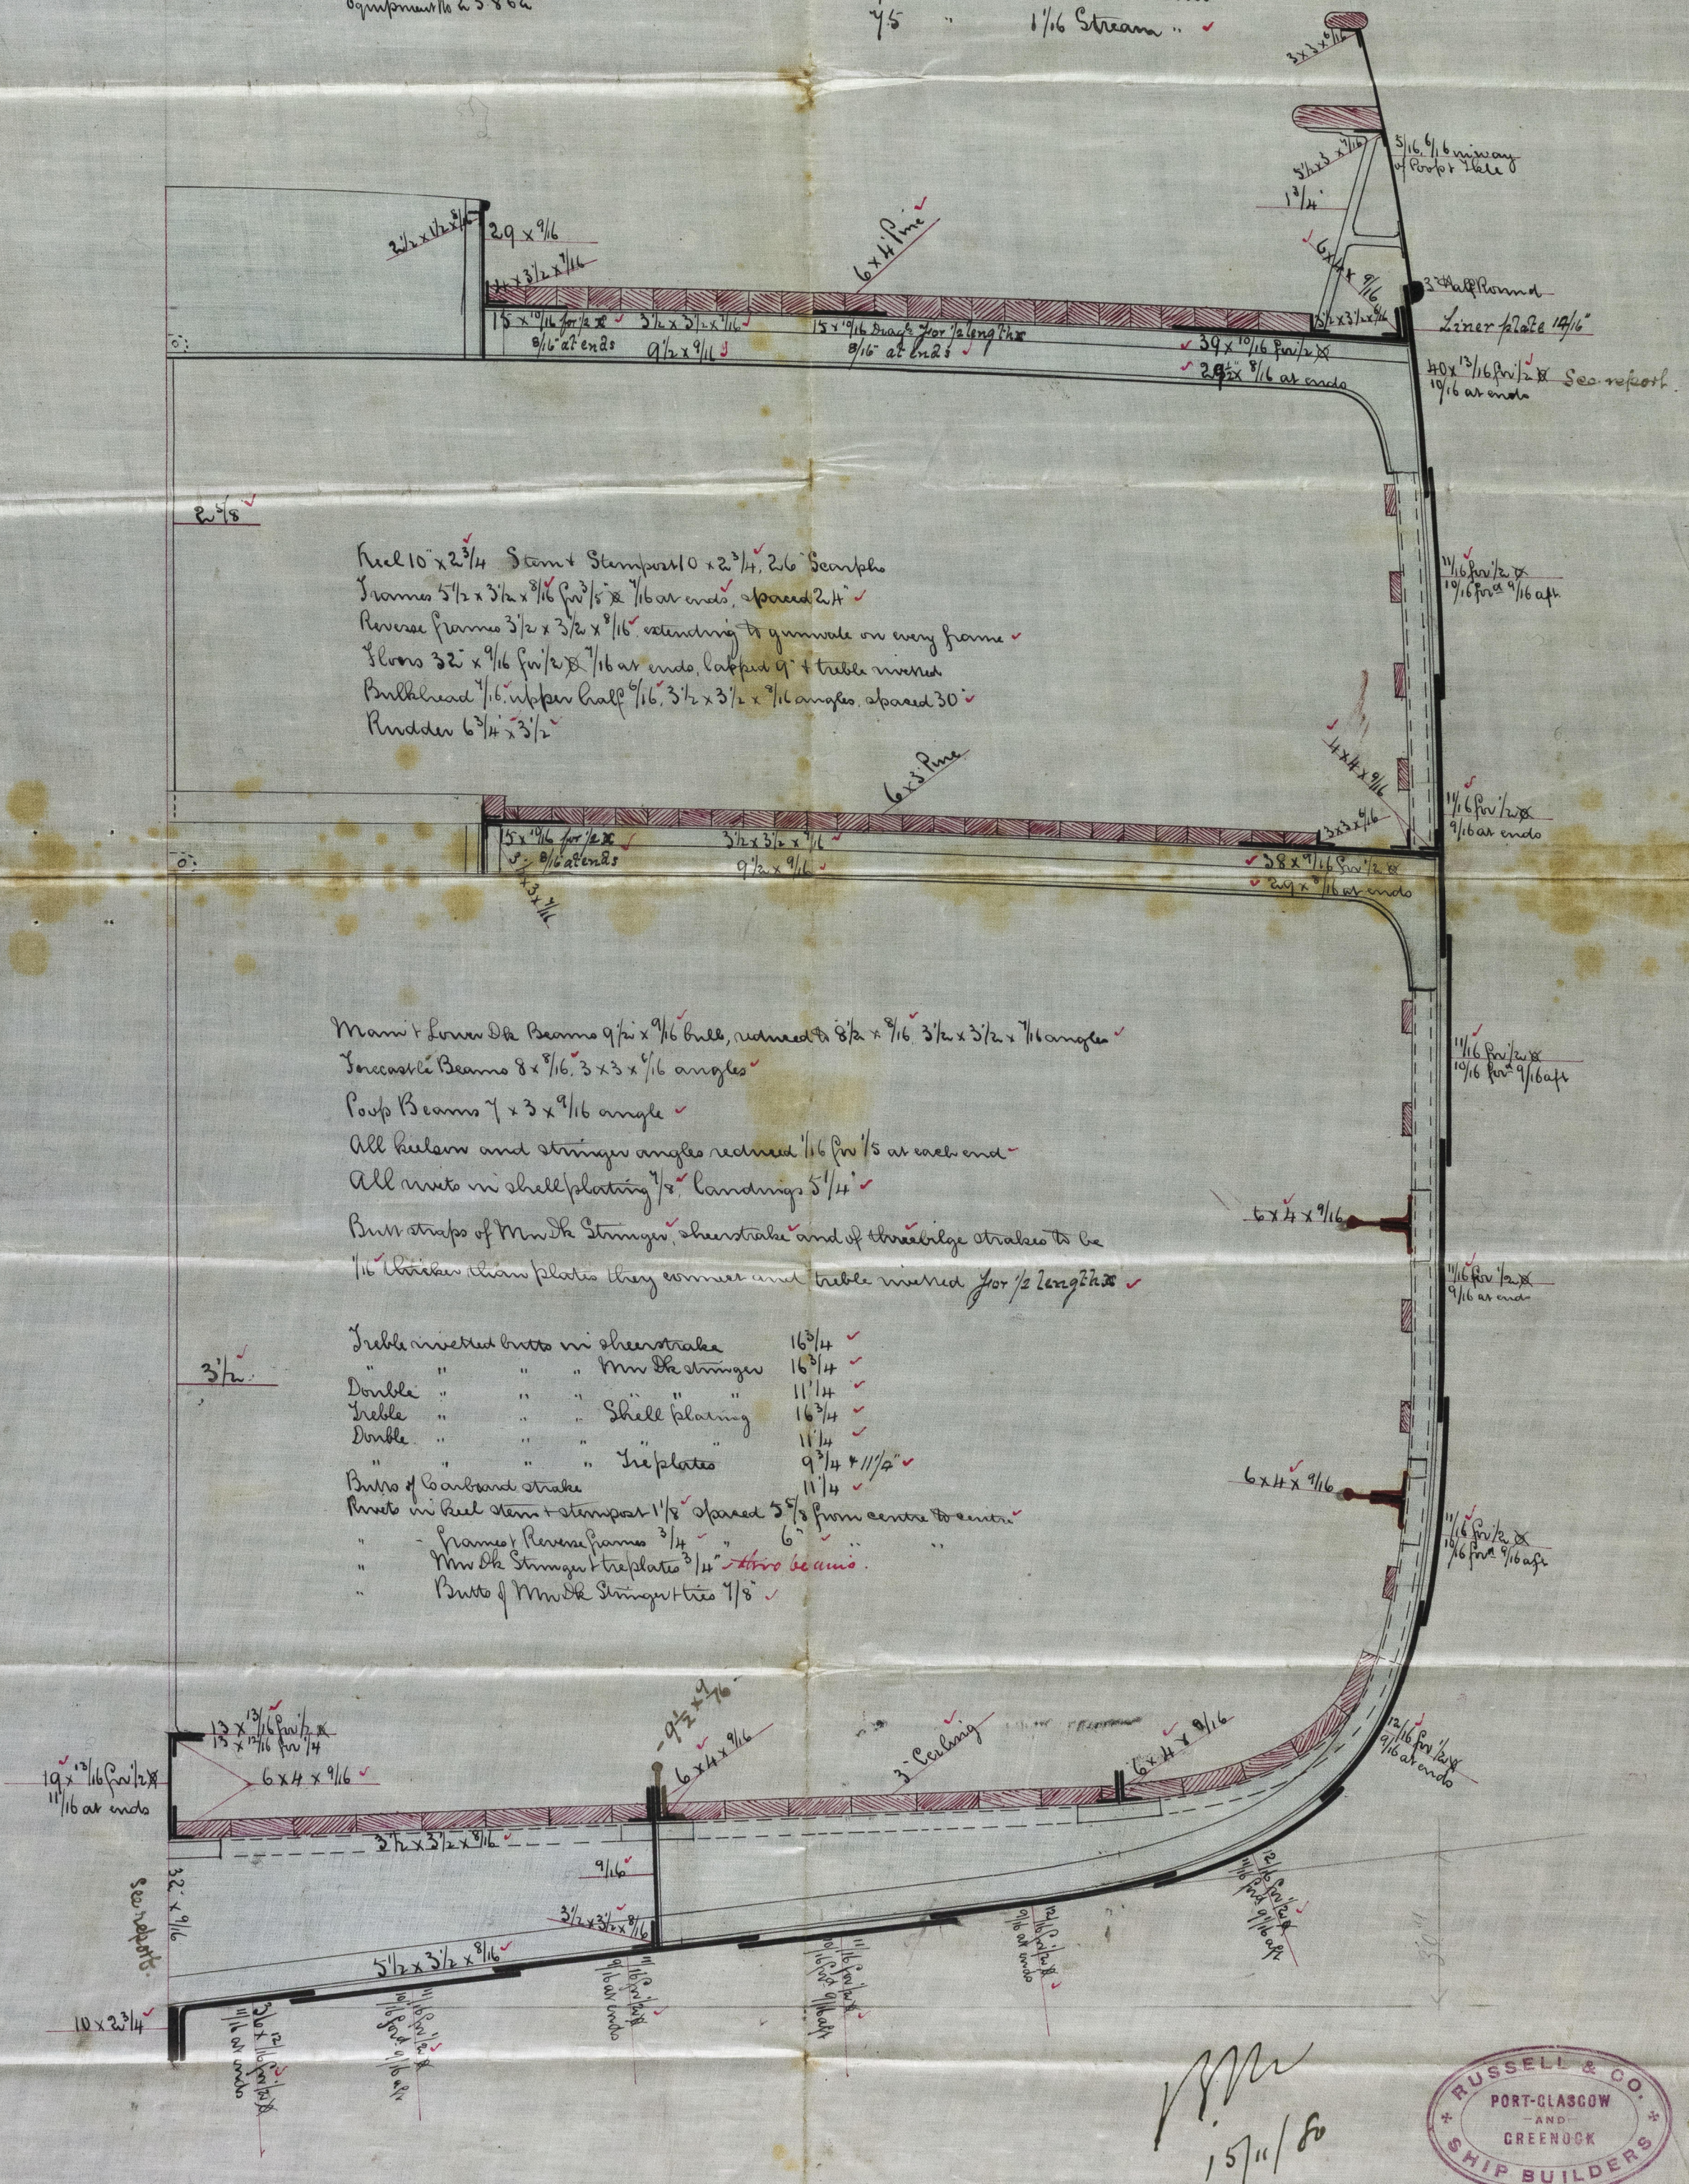

157" / 80

