


27.10.

S.S. "Teviotdale"  
Greenock Report No 8228

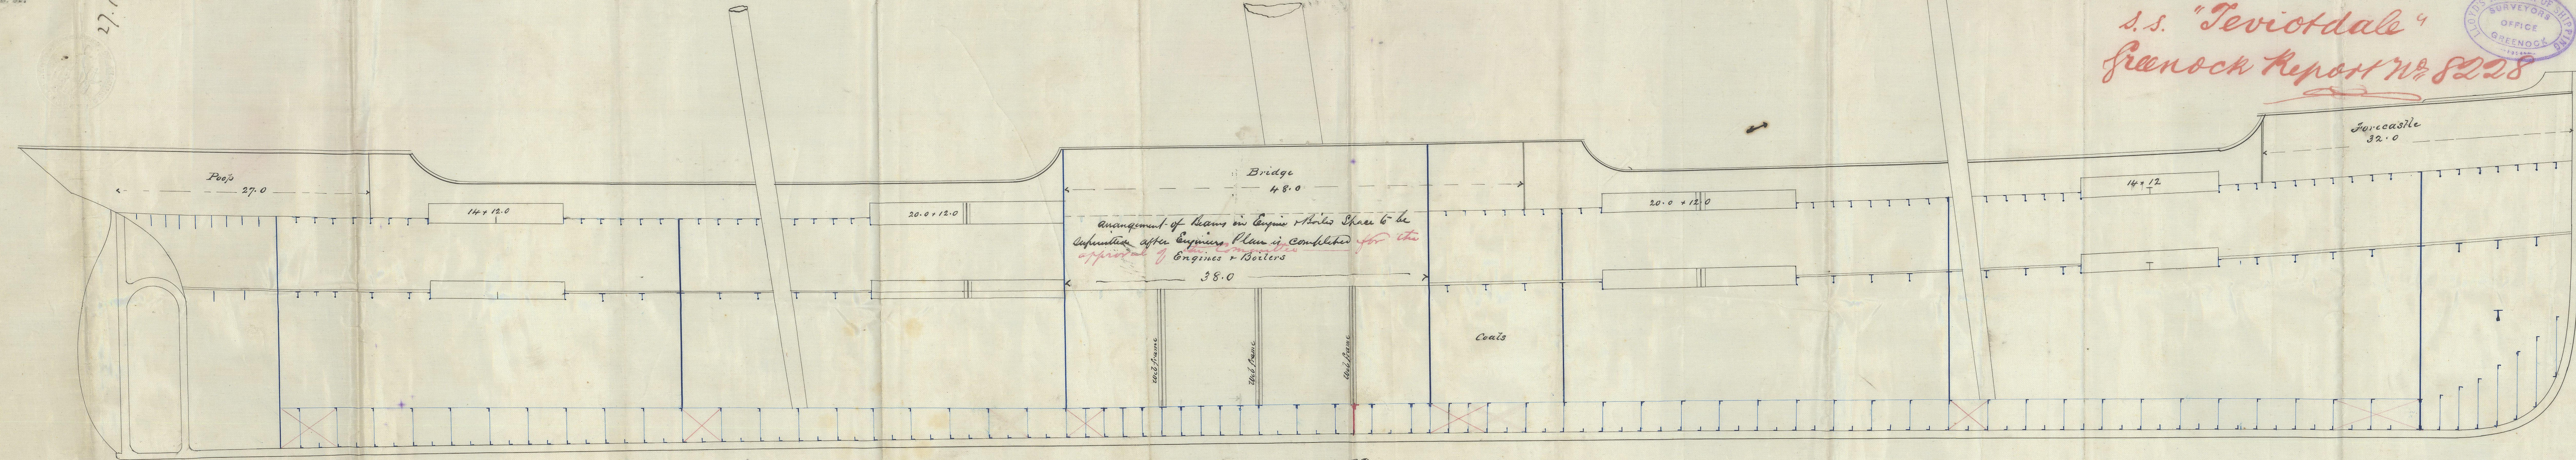

Longitudinal Section of S.S. No 121  
Scale 1/8 inch = one foot  
ROBERT STEELE & CO.,  
Shipbuilders & Engineers,  
GREENOCK.

© 2021  
Lloyd's Register  
Foundation

GRK 298-0106