



S.S. "Hye Leong"
Greenock Report No 8290

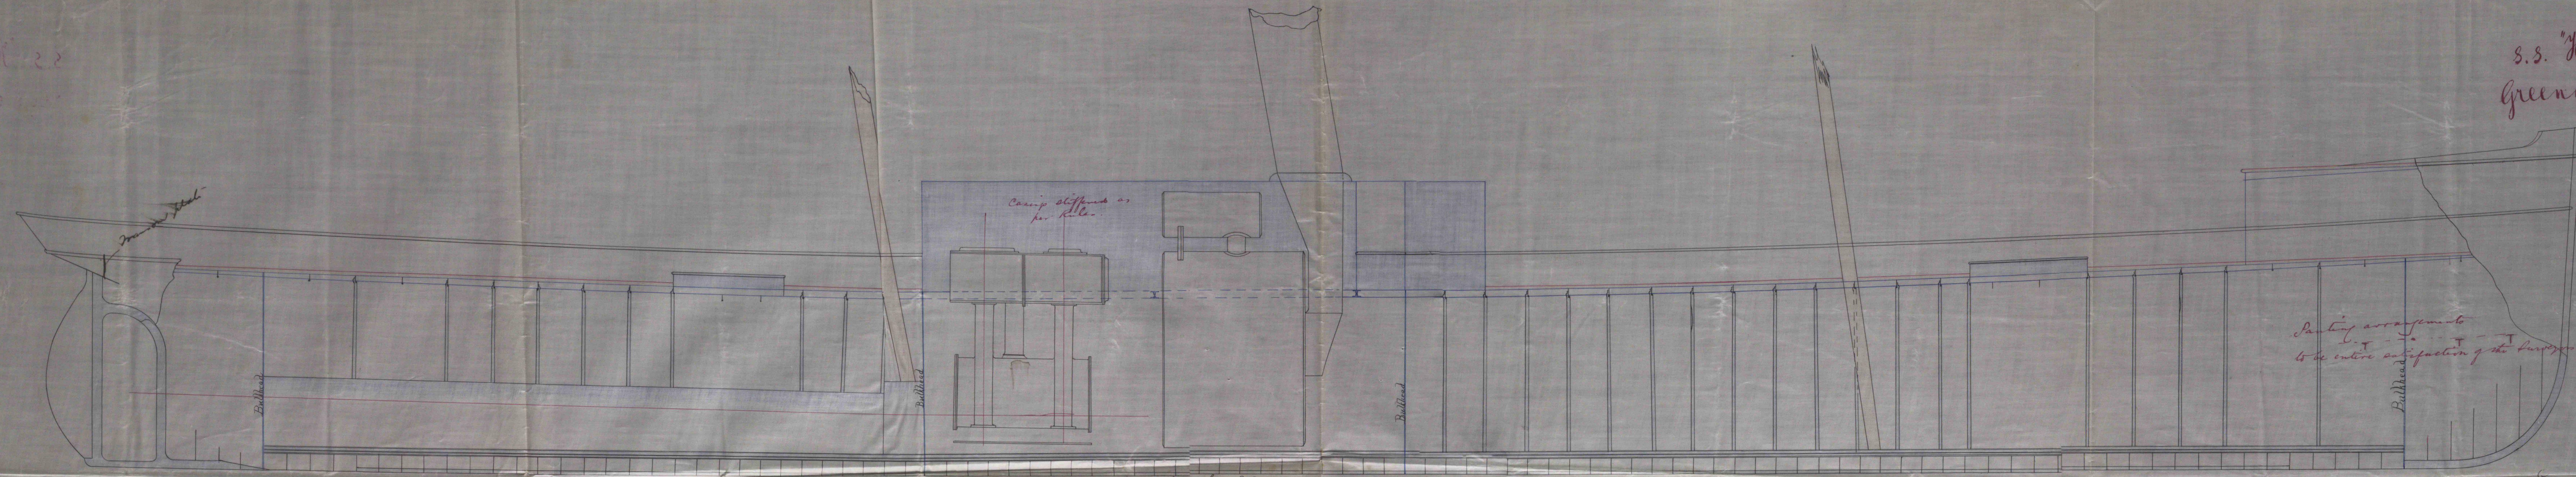

Frames 18" for half length Amidships, Ends 20"

Longitudinal Section & Main Deck Plan
Foreb' 178 SS.

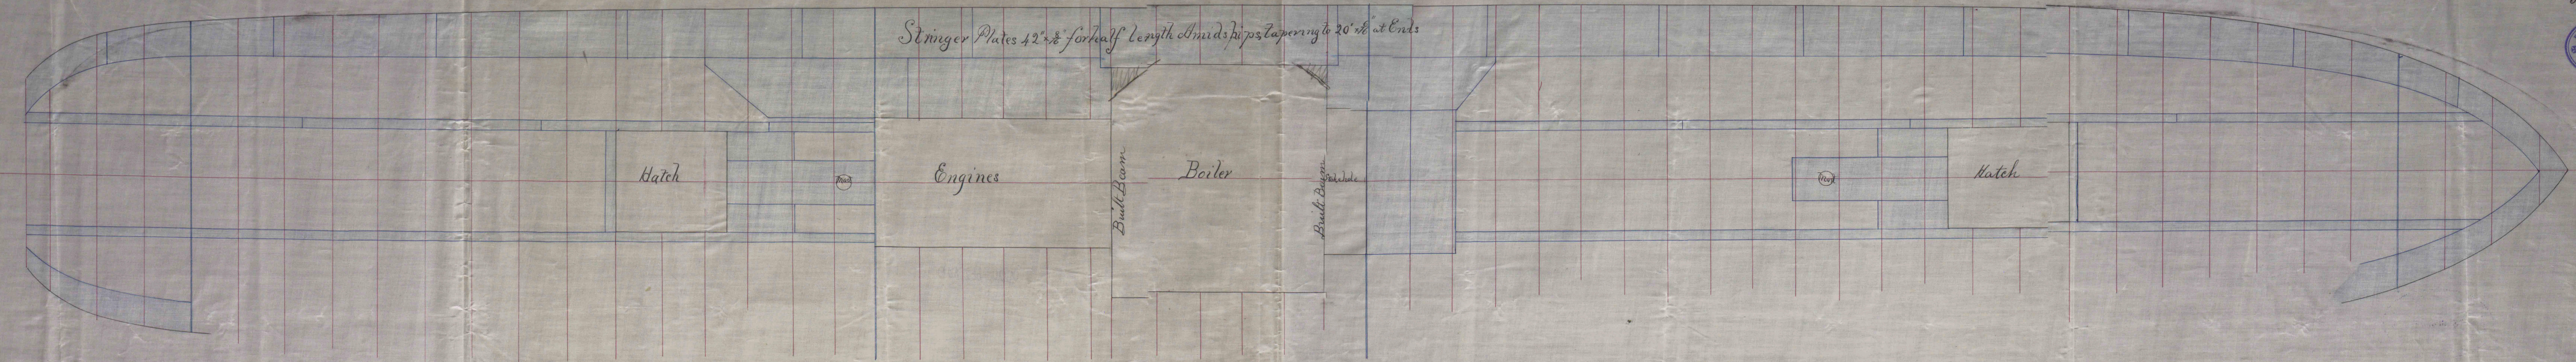


BLACKWOOD & GORDON
ENGINEERS
13 JUN 82
IRON SHIP BUILDERS
PORT GLASGOW

24/6/82