


28.11.81

S. S. "Hye Leong"
Greenock Report N^o 8290

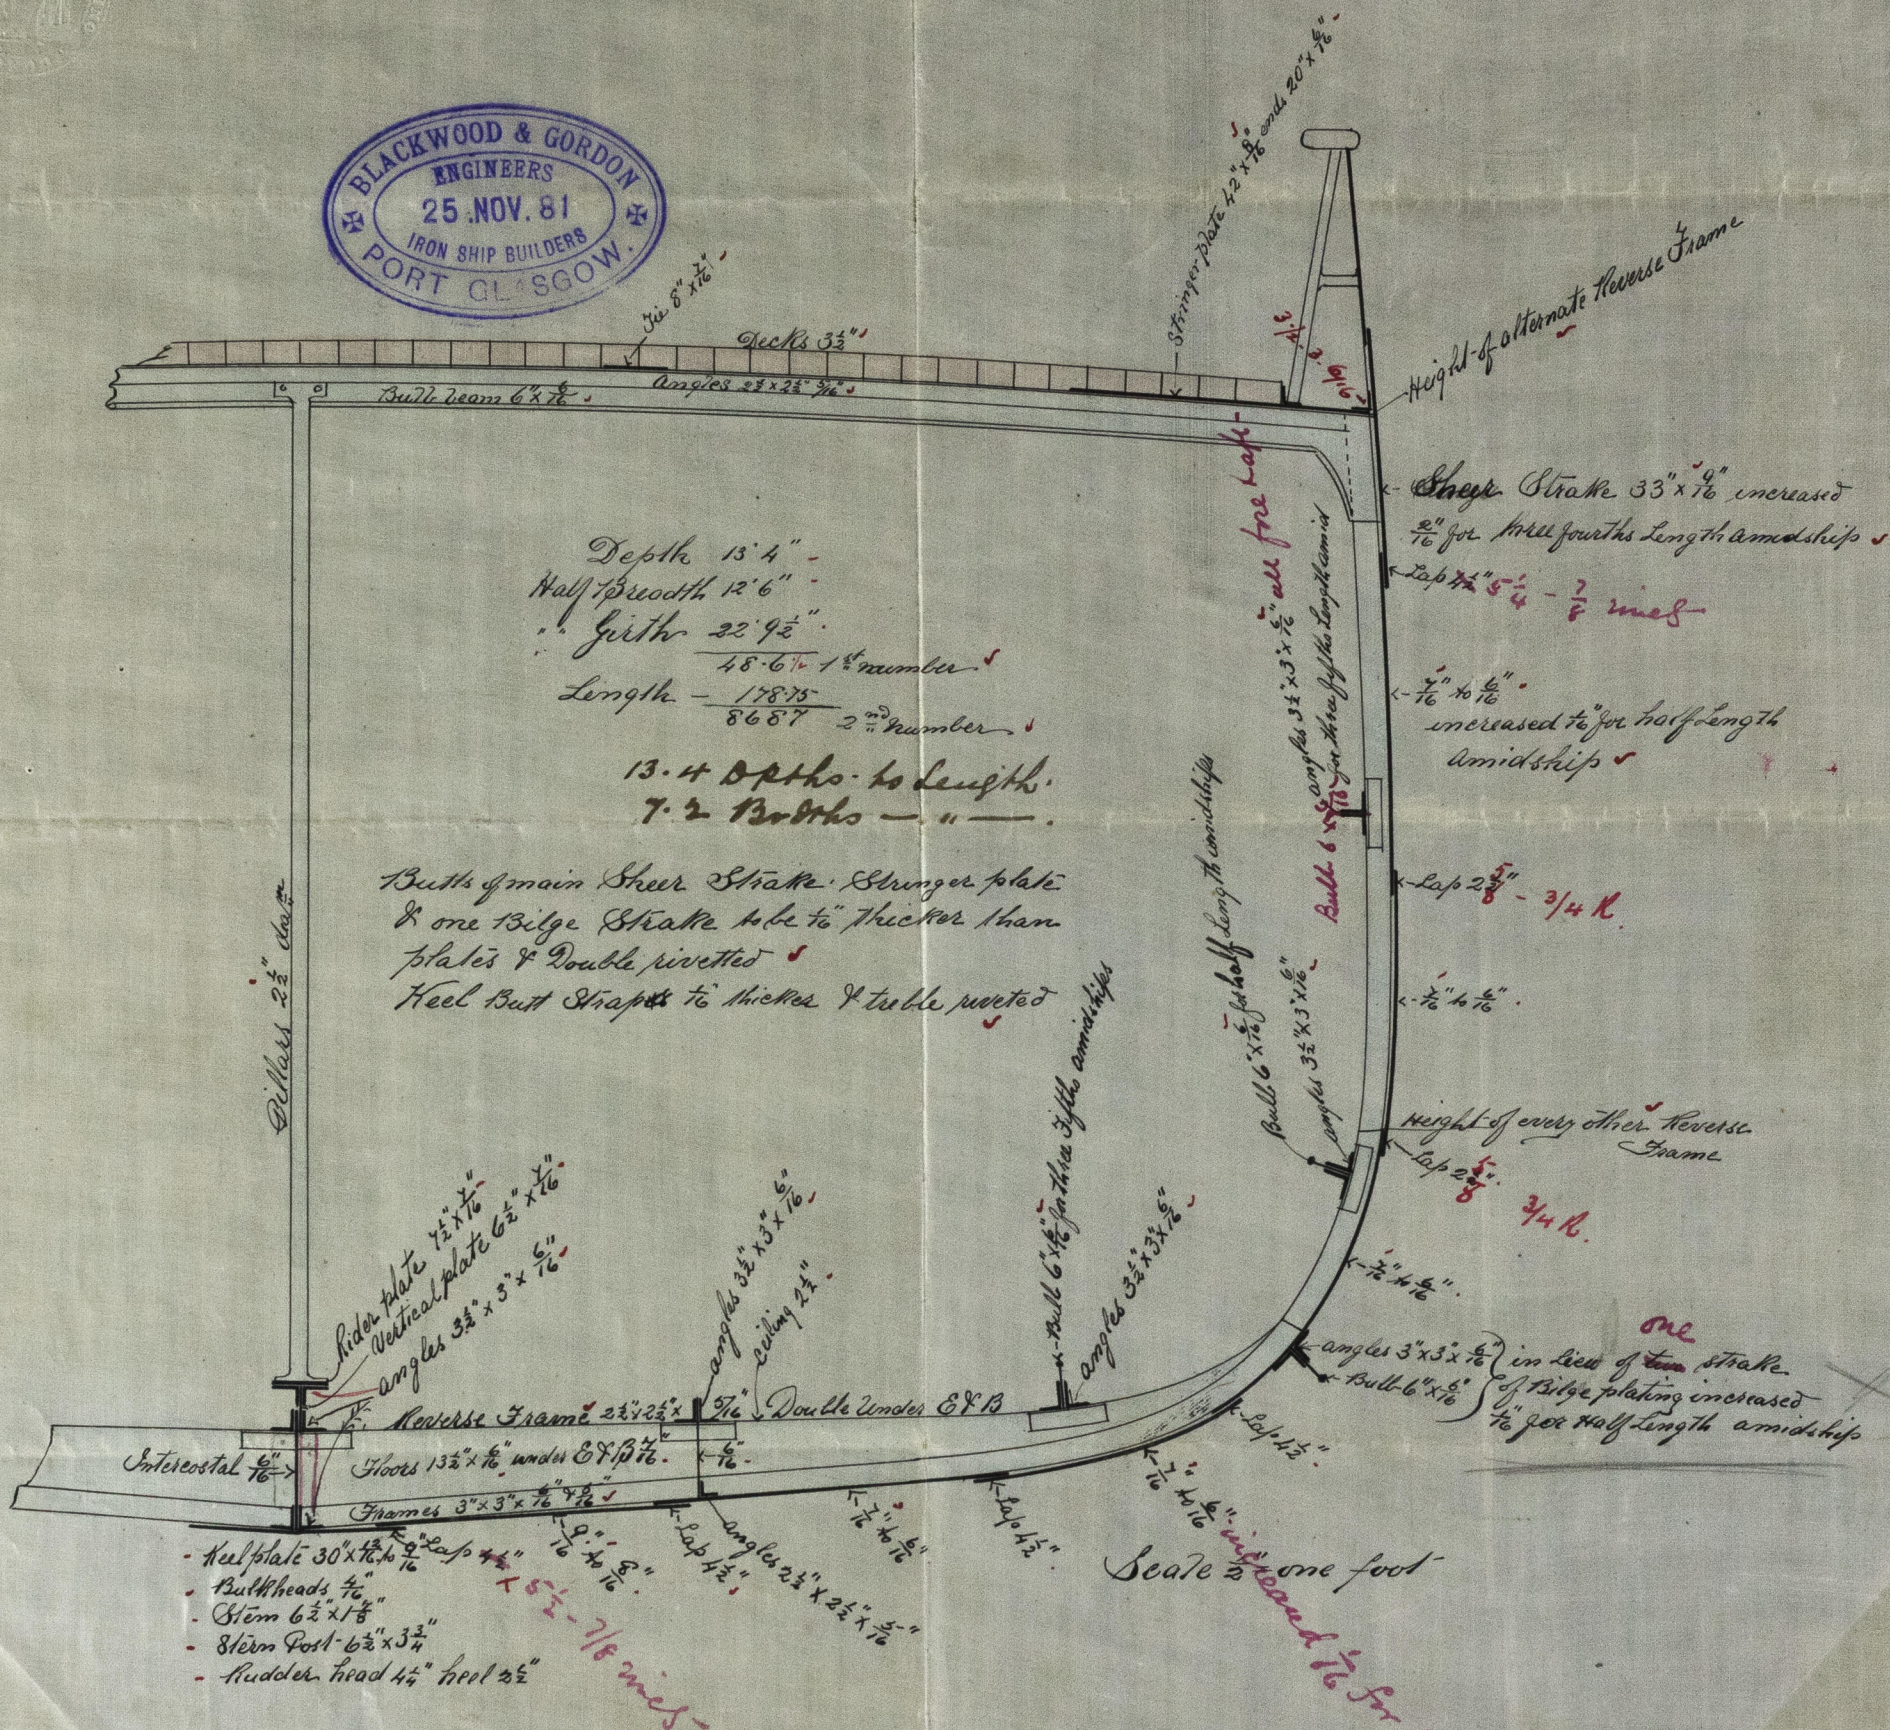

Scale $\frac{1}{2}$ " = one foot

GRK 198-0053

Lloyd's Register
Foundation