


RECEIVED 7 MAR. 82.

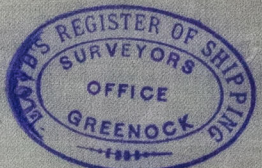

Ship "Clan Mackenzie"

Greenock Report, No. 8322




Sailing Ship No 185.

248.5 x 38.0 x 25.25 per Rule

Full Poop 32 ft long from Post, and Topgallant Forecastle
Class 100 A1 at Lloyds.

ROBERT DUNCAN & CO
SHIP BUILDERS
PORT GLASGOW.

2nd Jan 1882

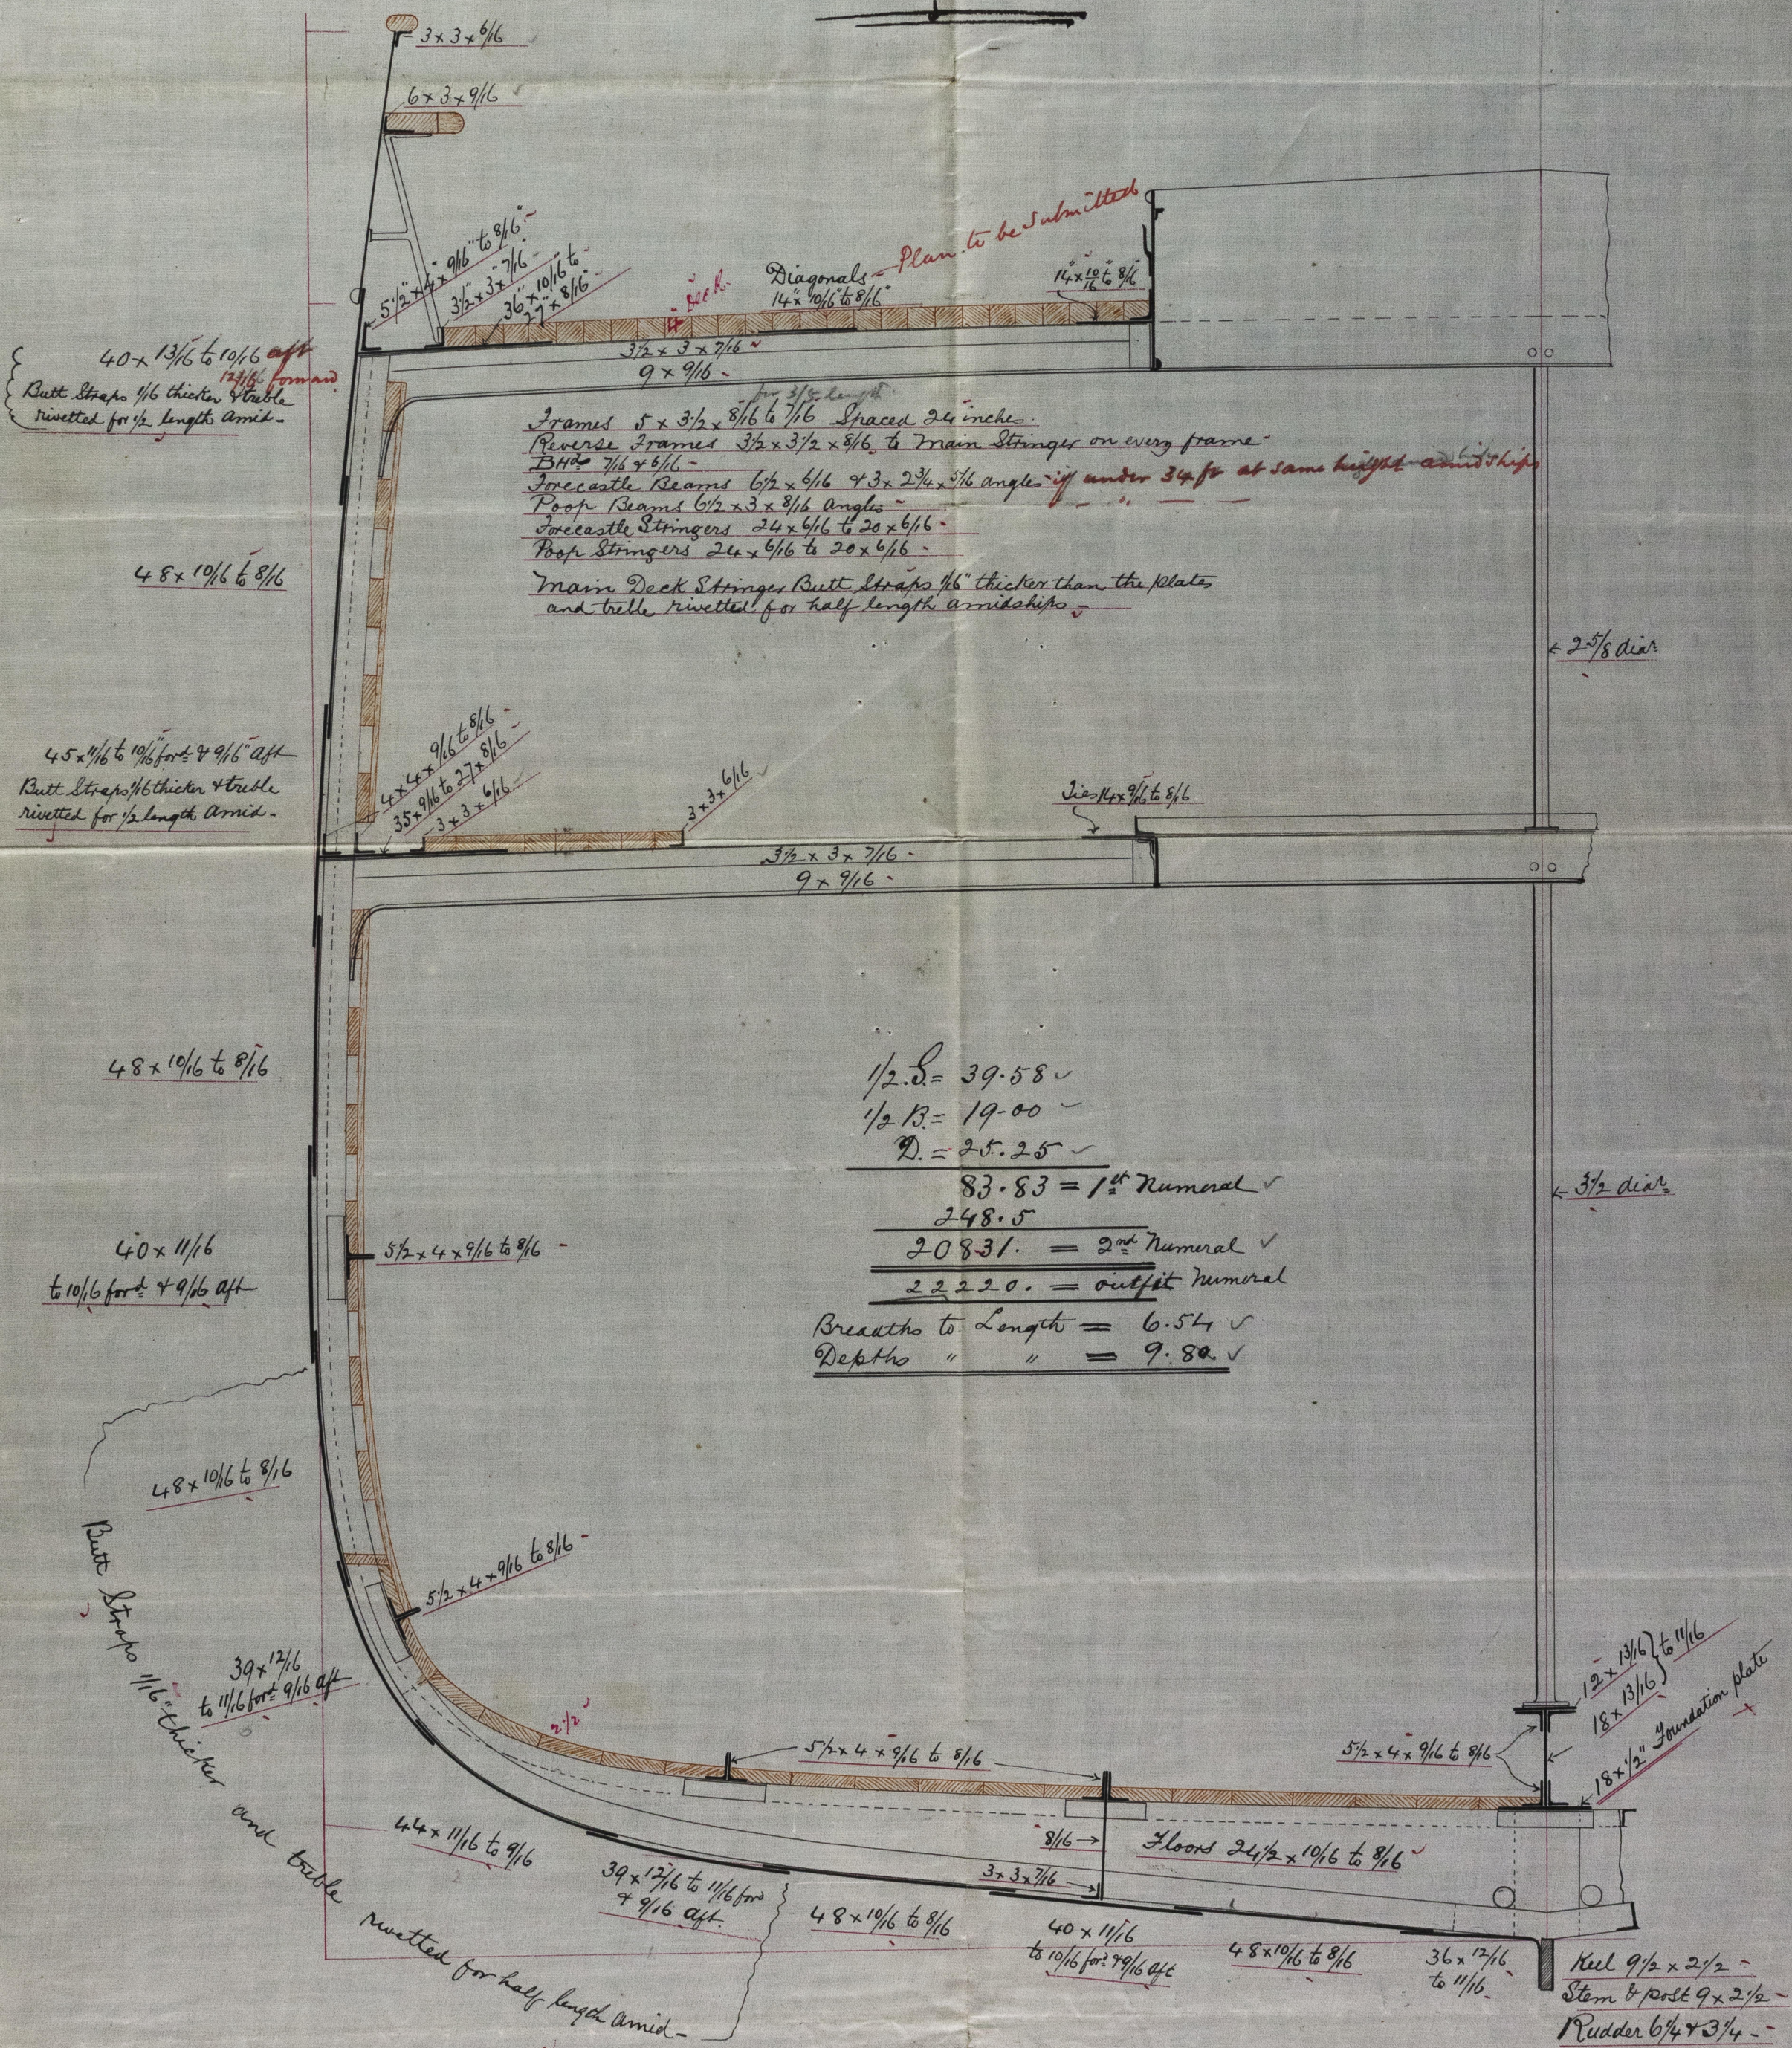

1/2 L = 39.58 ✓
1/2 B = 19.00 ✓
D = 25.25 ✓
83.83 = 1st Numeral ✓
248.5
20831. = 2nd Numeral ✓
22220. = outfit numeral
Breaths to Length = 6.54 ✓
Depth " " = 9.80 ✓

SCALE 1/2 INCH TO A FOOT.