





Beams of 9 x 7/8 Galt & single 3/4 x 3/4 Angle Iron
at the ends of each Cargo Hatch on the Main &
Tween Decks
Masts wedged at the Main Deck

 

Ship "Clan Mackenzie"
Greenock Report, No. 8322

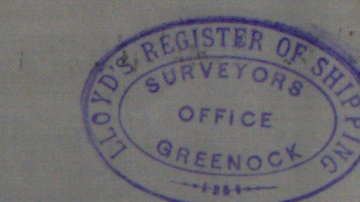

PLAN of DECKS
SHIP No. 185

Scale 1/2 inch = 1 foot

ROBERT DUNCAN
Shipbuilders
PORT GLASGOW
6/1/85