


S.S. "Brinio"
Greenock Report No 8327

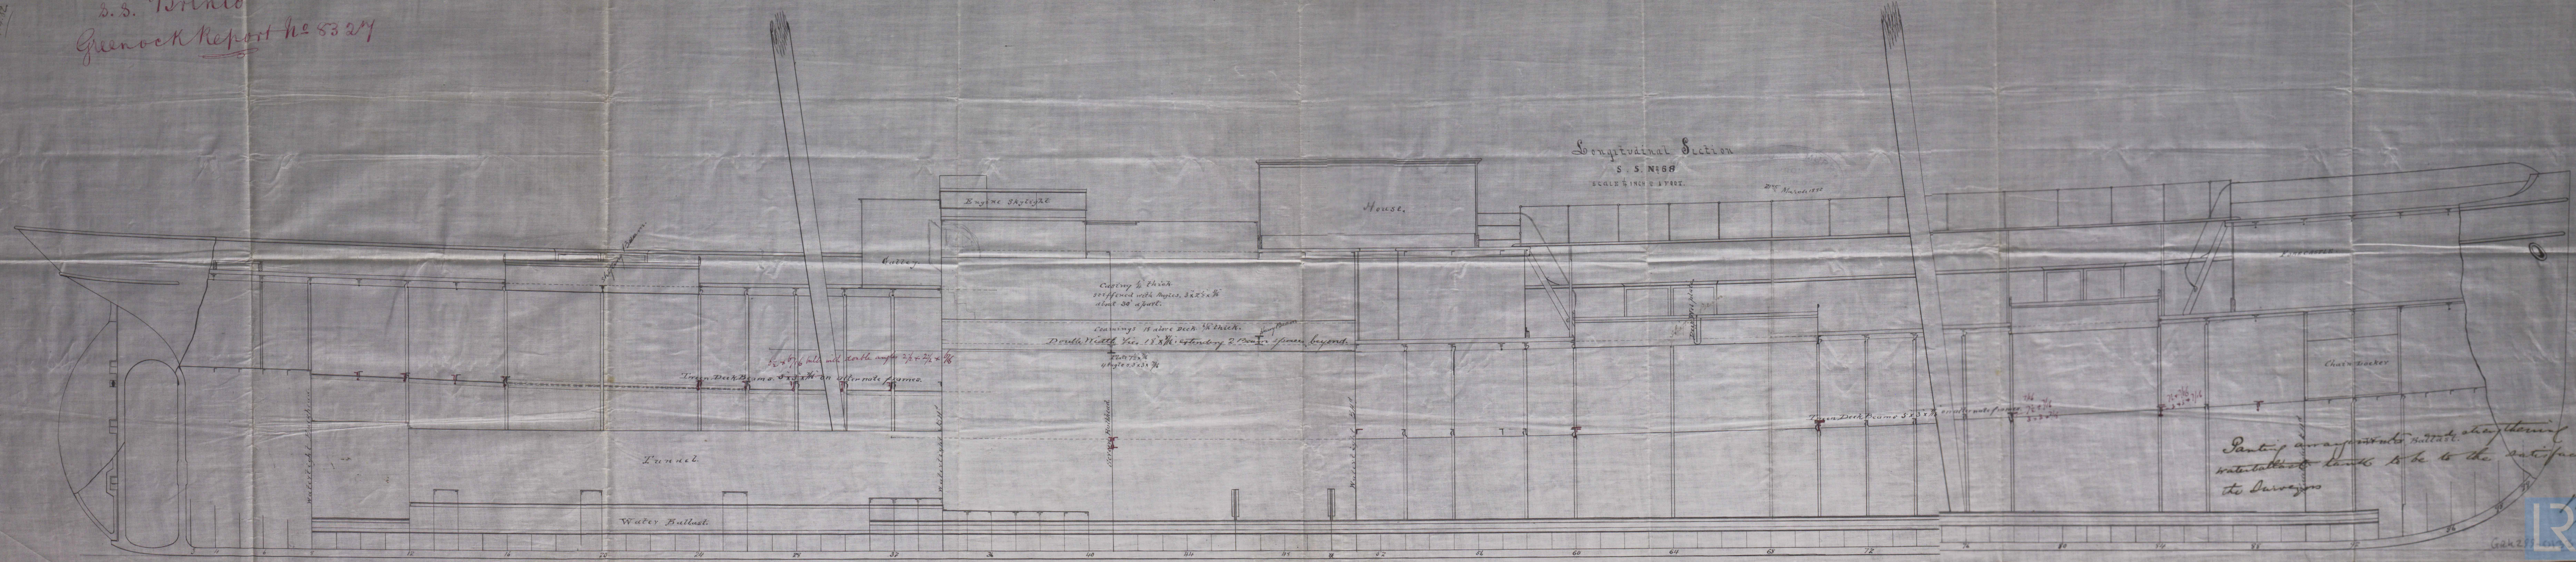

Longitudinal Section
S. S. No 68

SCALE 1/4" = 1 FOOT.

20th March 1882

Panting arrangements to be to the satisfaction of the Surveyors