

RECEIVED 23 MAR 82
RECEIVED 23 MAR 82


S.S. "Brinio"
Greenock Report No. 8327

Dr. to G. 11/4/82

Handed to Pumping Engineer

Pumping arrangement
S.S. No. 68
Scale 1/4 inch = 1 foot

Over 77
22nd 11/11/82

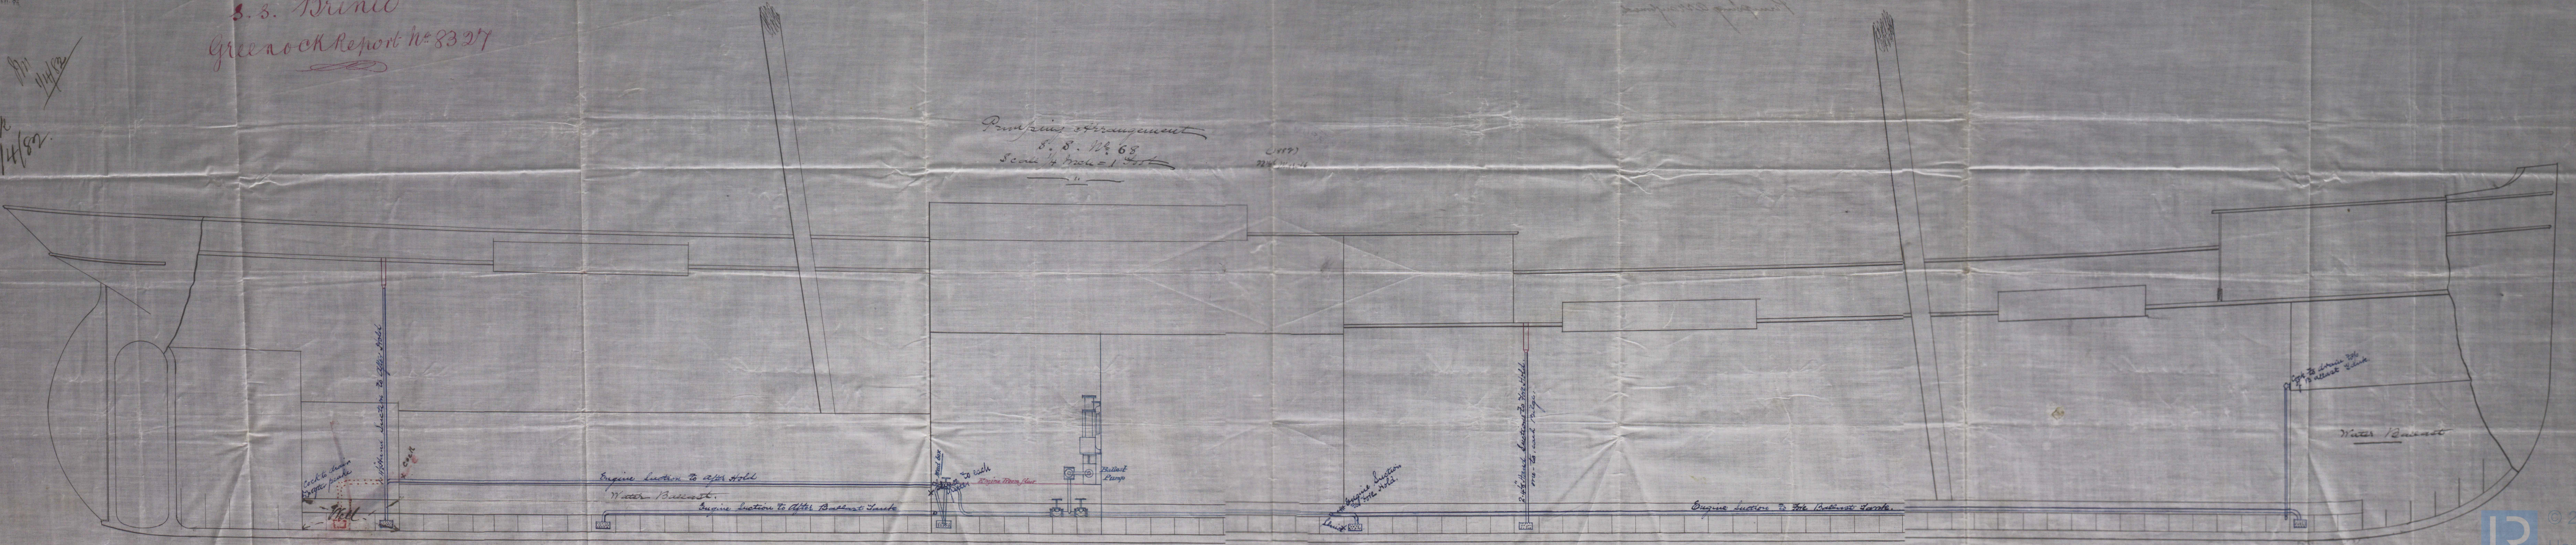

Murdoch & Munro No 68
Pumping arrangements

GRK 298-0134

Engine suction to after hold

Water Ballast.

Don't think it is correct



Lloyd's Register
Foundation