


Cr. to Crk 15.9.82

# 1/2 Midship Section

of Barque No 66 (class 100. a. l.)  
Scale 1/2" = 1 foot

Bk. J. T. "North," Greenock Report No. 8124


Register dimensions 198.6 x 31.6 x 18.6.

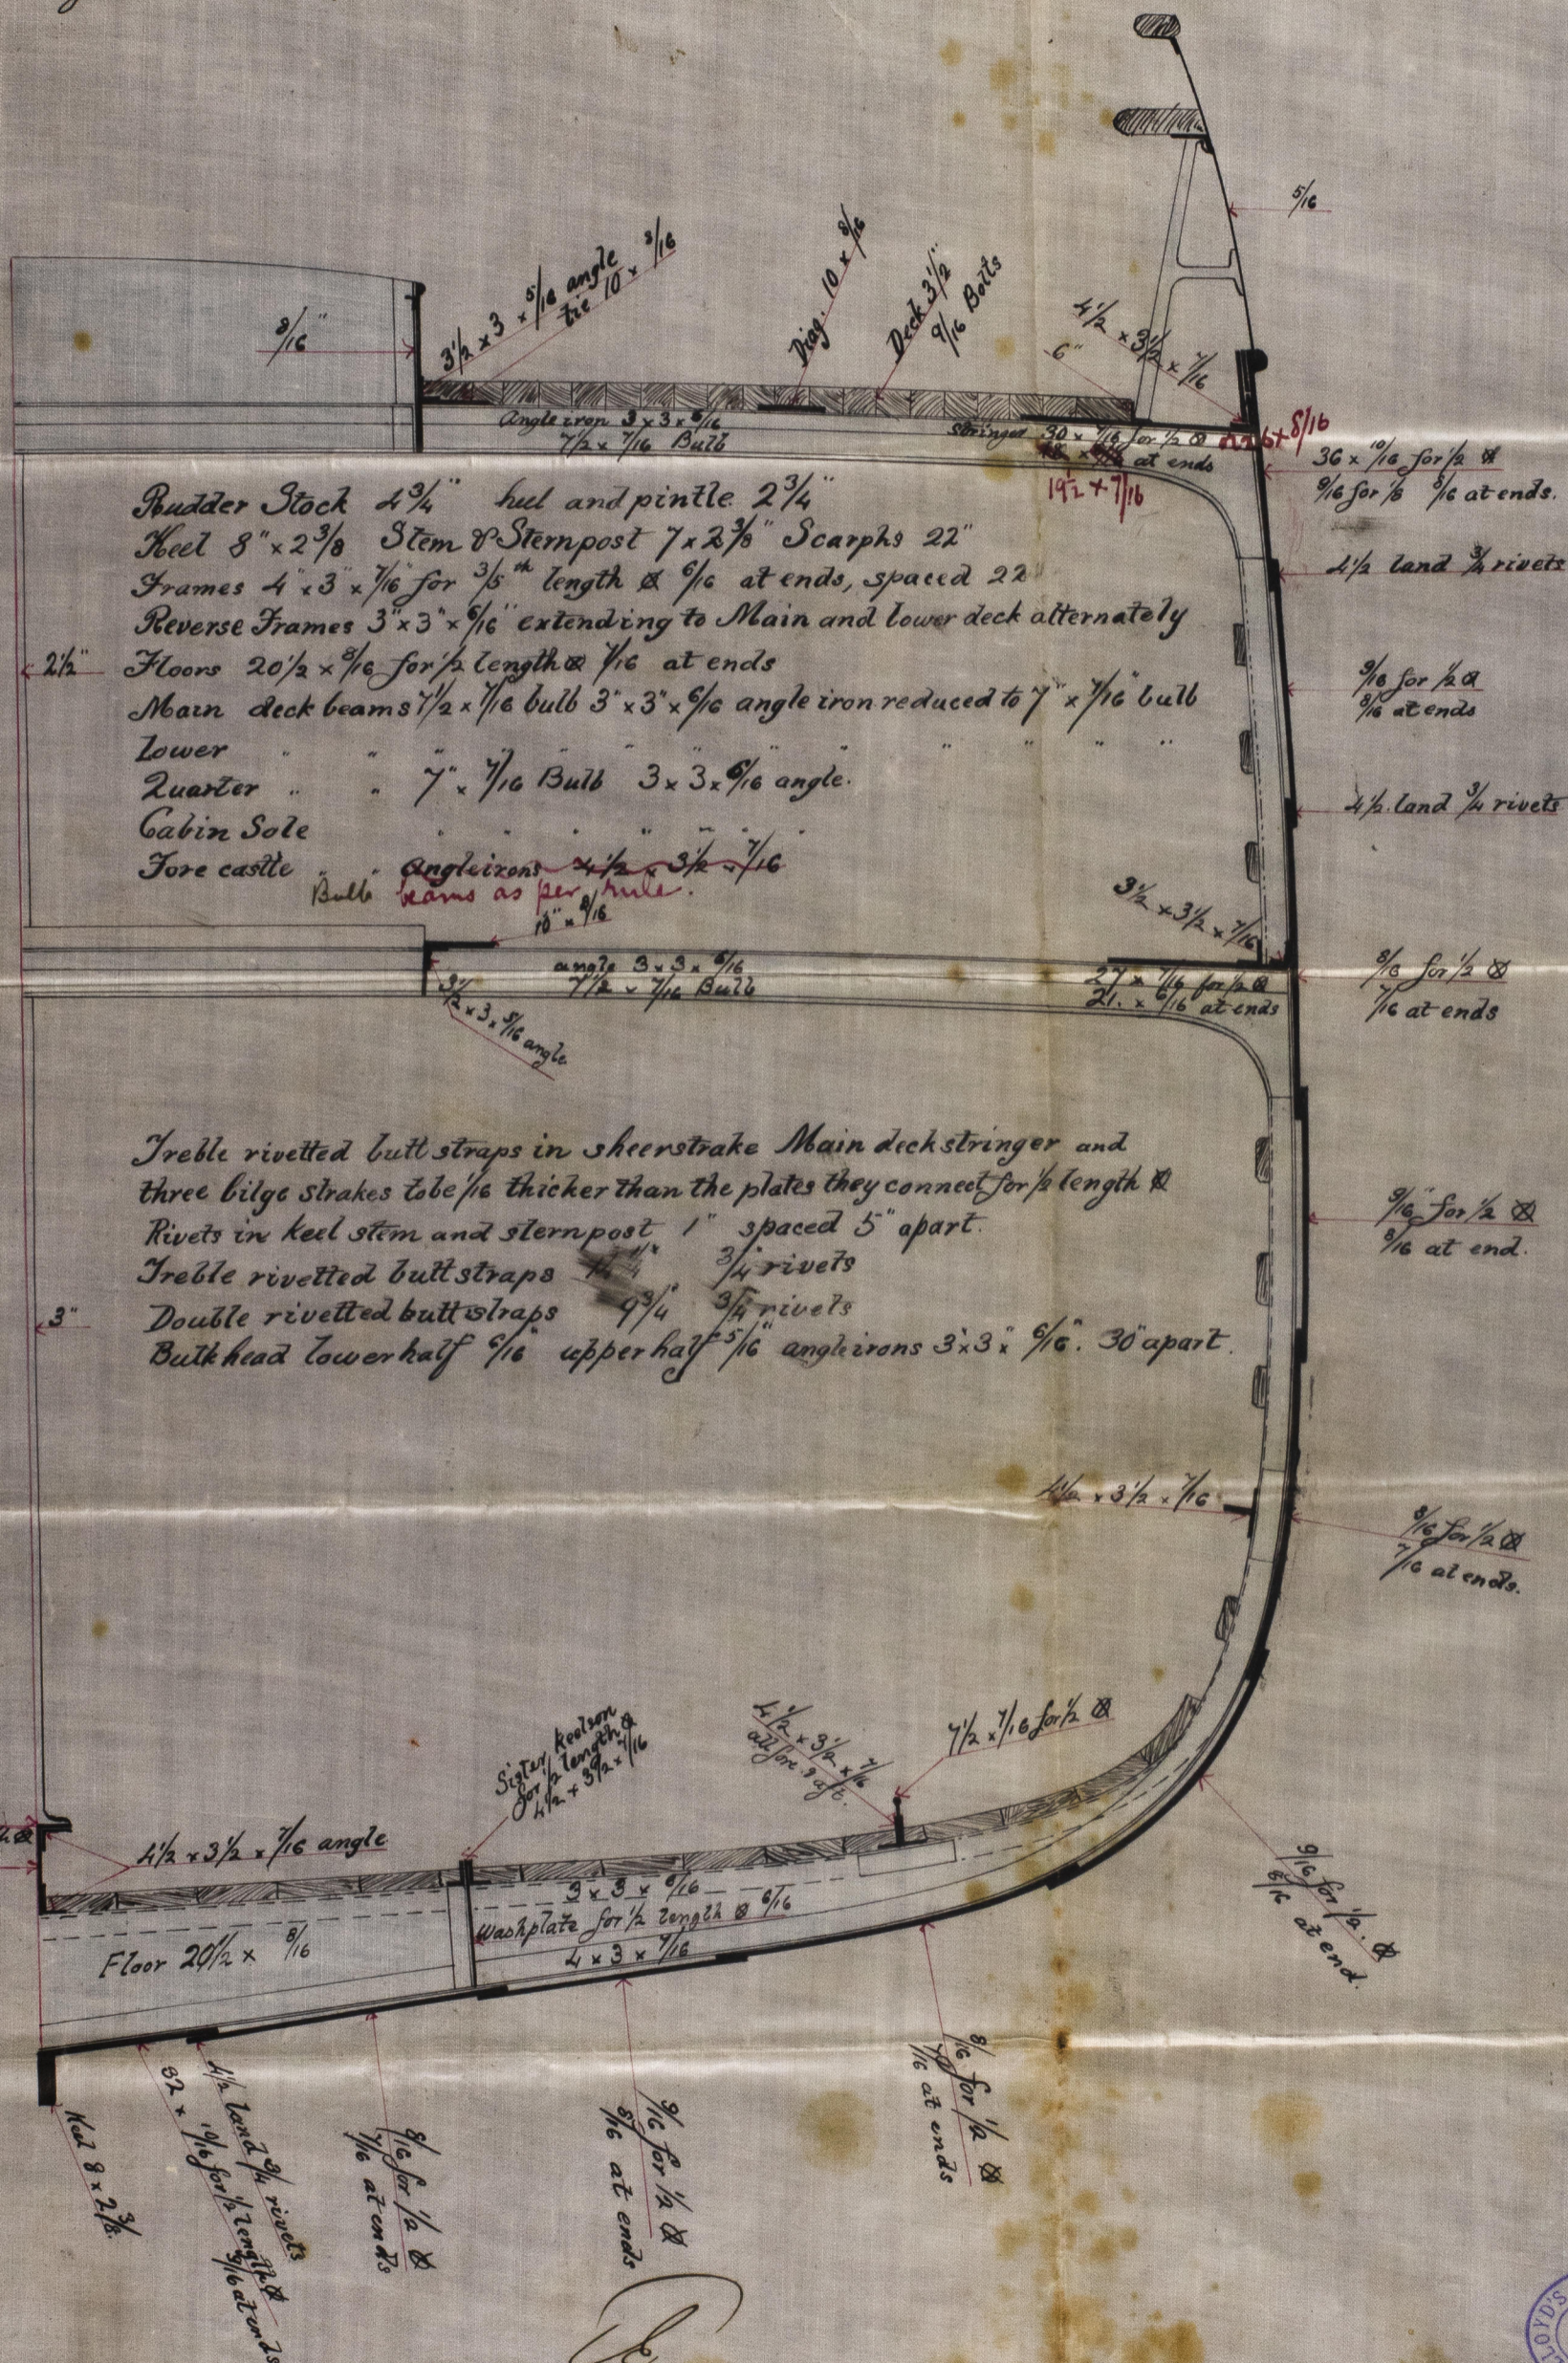

1/2 Breadth	15.65
1/2 Girth	31.8
Depth	20.4
	67.85 1st Numeral.
Length	189.5
	339.25
	61065
	54280
	6785
	12857 2nd Numeral.
	857.15 1/5 added for Quarter Deck
	13714.75 Equipment No.

## Equipment

1 Bower excl stock	25 1/2 Cwt
1 " " "	25 1/2
1 " " "	21 3/4
1 Stream	8 1/2
1 Hodge	4 1/4
1 " " "	2 1/4
270 Gathens Stud chain	1 1/16
75 " Stream	14 1/16
90 " Rope	10"
90 " " " " " " " "	8"
90 " " " " " " " "	5"

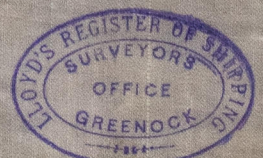

15/9/82