

RECEIVED 11th NOV. 82.  
RECEIVED 11th DEC. 82.  
RECEIVED 11th MAR. 83.

OK "R. A. Calderon"  
Greenock Report No. 5510

GNR  
17/11/82 & 19/12/82  
10/3/83

# Half midship Section

Proportions

6 1/2 Breadths 6.05

8 1/2 Depths 8.7

of Barque No. F

Half Breadth 15.5

" Girth 33.05

Depth 21.5

40.05

187


490 3 5

560 4 0

700 5

13099.35

To be built of  
Steel & to Class  
100 A.

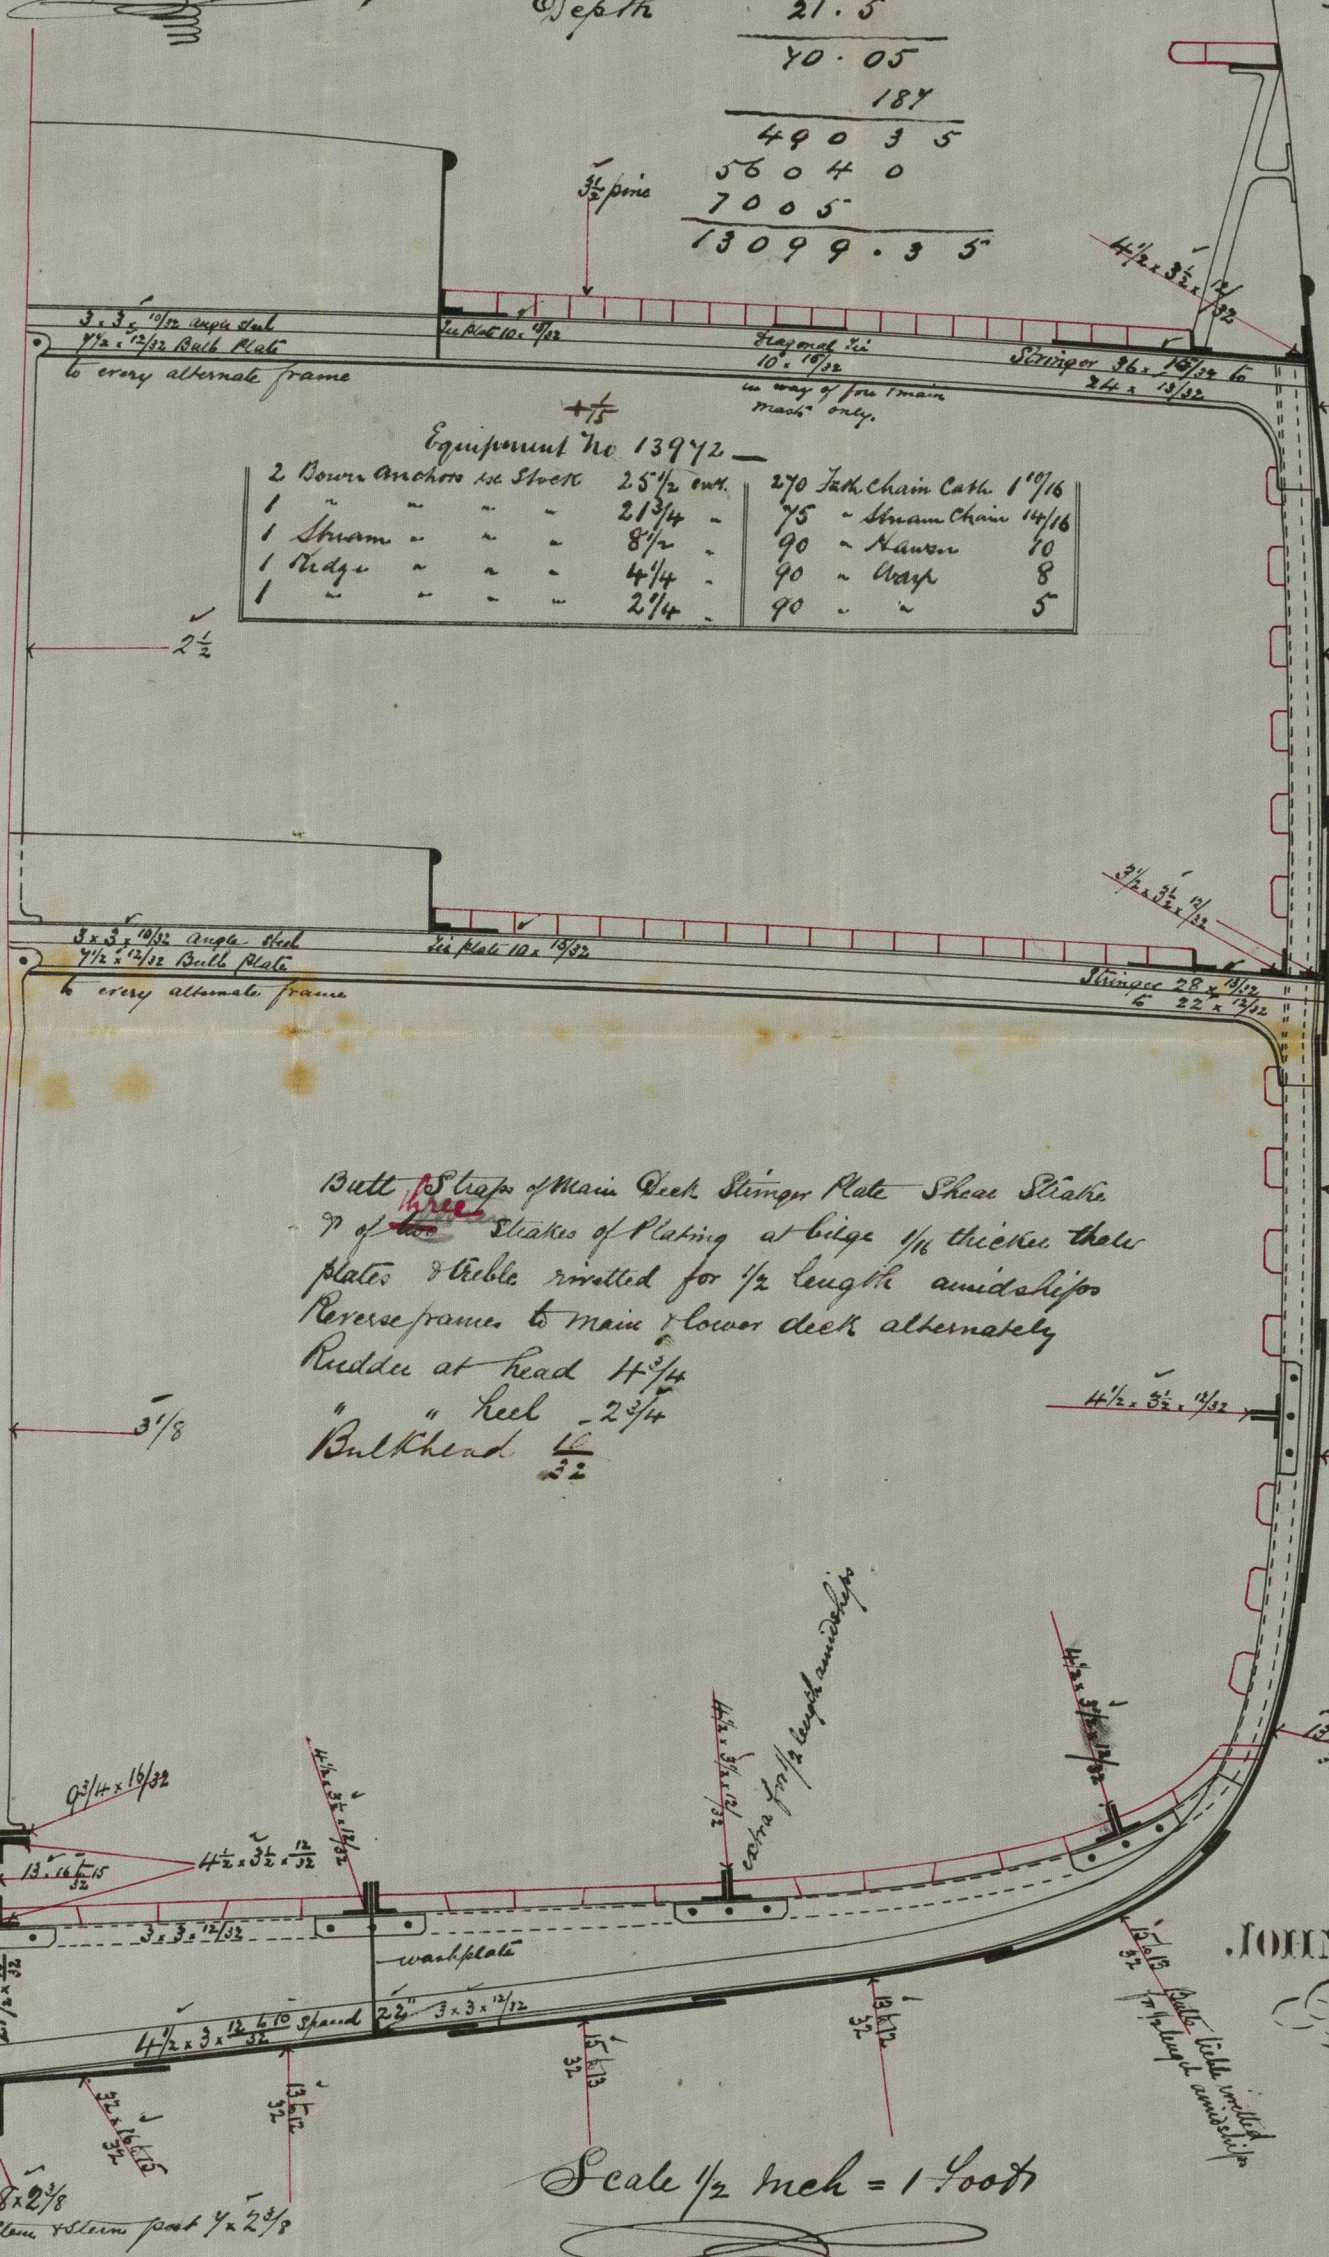

Equipment No 13972

2 Down Anchors 1st Stock	25 1/2 out.	270 Tack Chain Cable	1 1/16
1 " " "	21 3/4	75 " Stream Chain	1 1/16
1 Stream " " "	8 1/2	90 " Hauler	10
1 Bidge " " "	4 1/4	90 " Wray	8
1 " " "	2 1/4	90 " "	5

Butt ~~free~~ Straps of Main Deck Stringer Plate Shear Strake  
of ~~the~~ Strakes of Plating at bilge 1/16 thicker than  
plates & double rivetted for 1/2 length amidships  
Reverse frame to main & lower deck alternately  
Rudder at head 14 3/4  
" " keel 2 3/4  
Bulkhead 16  
22

Scale 1/2 inch = 1 foot

JOHN REED & CO  
Ship Builders  
PORT GLEASON  
1882.  
J. R.