



Dr. A. Calderon
10/3/83

Dr. "R. A. Calderon"
Greenock Report No. 8510

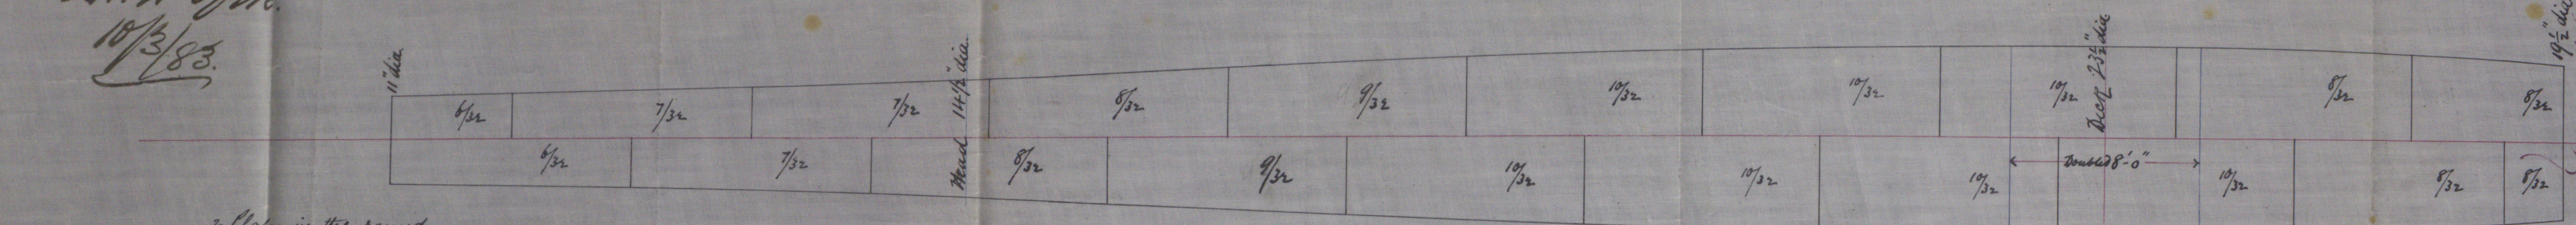


2 plates in the round
3 angles 3 1/2 x 3 x 1 1/2 to masthead
2 angles from there up.
In fore main
mast.

Stems of fore main 1 1/2" in mast double riveted to head. Single riveted beyond that.

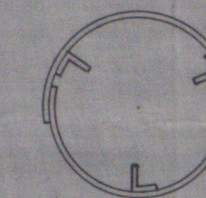


Fore Mast.

Under deck	19-6
Deck to hounds	34-0
Masthead	11-0
Topmast	19-0
Topmast head	5-0
Overall	91'-6"

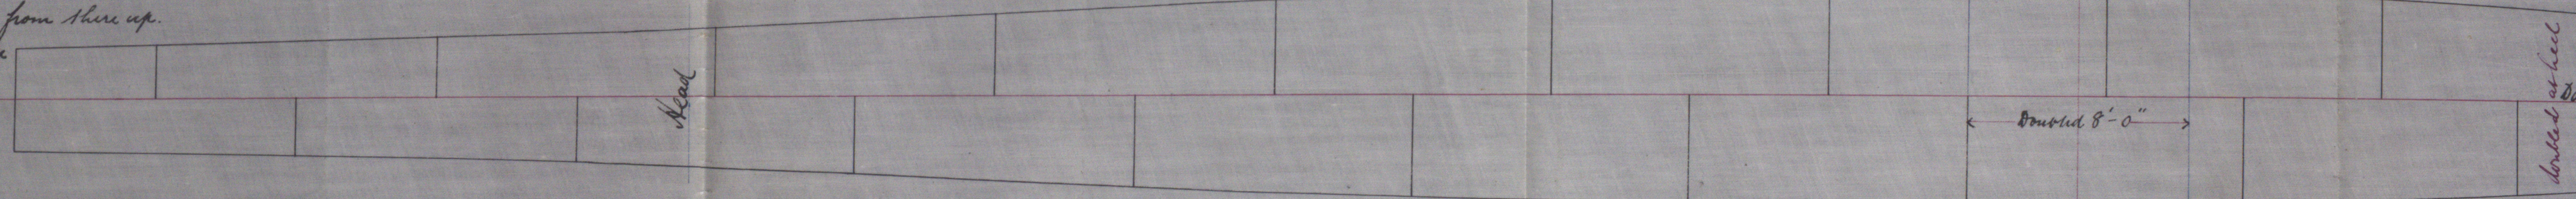

Main Mast.

Under deck	18-8
Deck to hounds	39-0
Masthead	11-0
Topmast	19-0
Topmast head	5-0
Overall	92'-8"

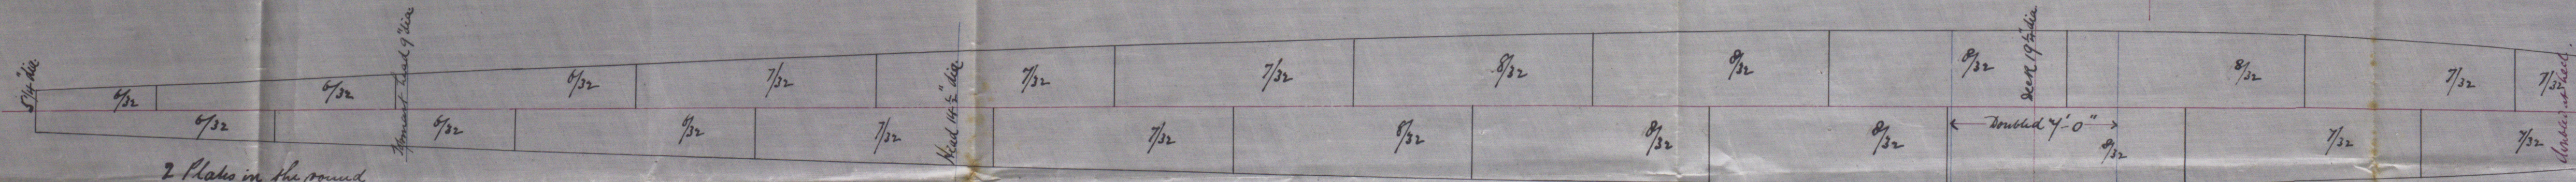

2 plates in the round
2 angles 3 1/2 x 3 as far as practicable
In Mizzen mast.


Mizzen Mast

Under deck	23-2 1/2
Deck to hounds	36-4
Masthead	9-0
Topmast	22-10
Topmast head	15-6
Overall	106'-10 1/2"

Short Spike Bowsprit.

2 plates in the round


27'-0" outside bed

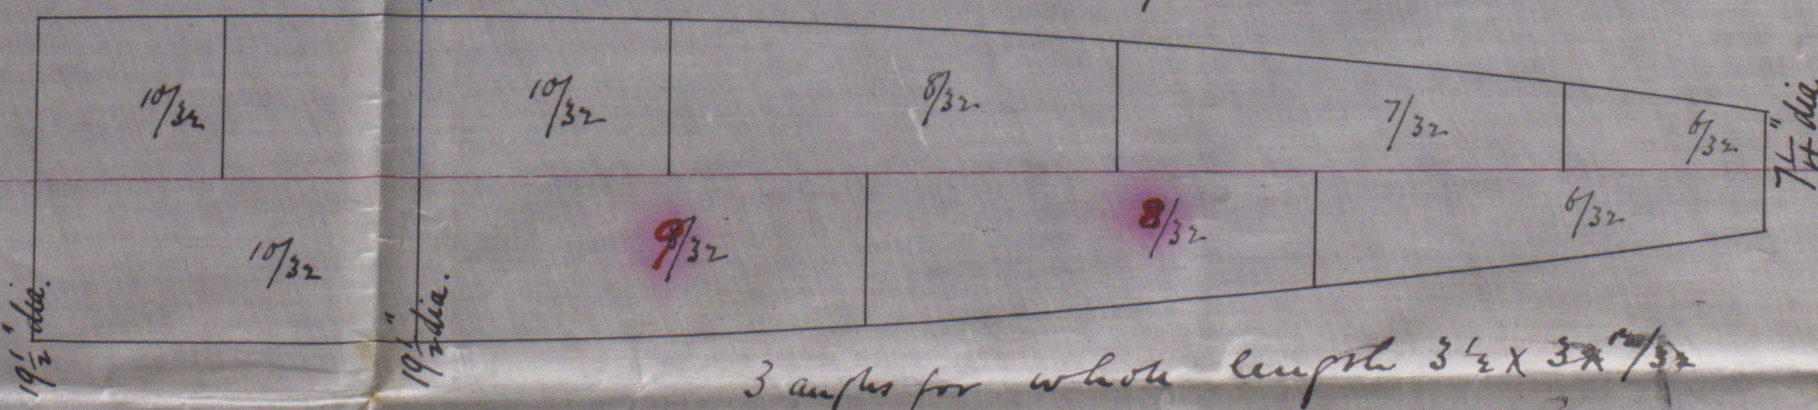


Short Spars & Mast

for Barque No. 7/F


3/3/83
P.H.
A.B.S.

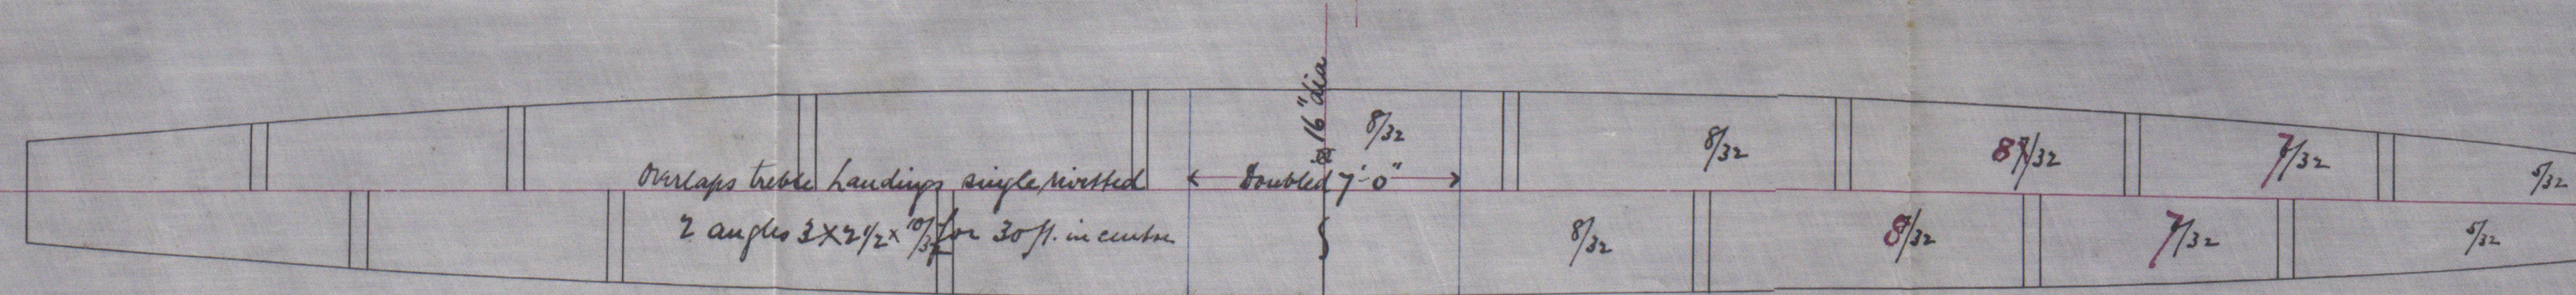


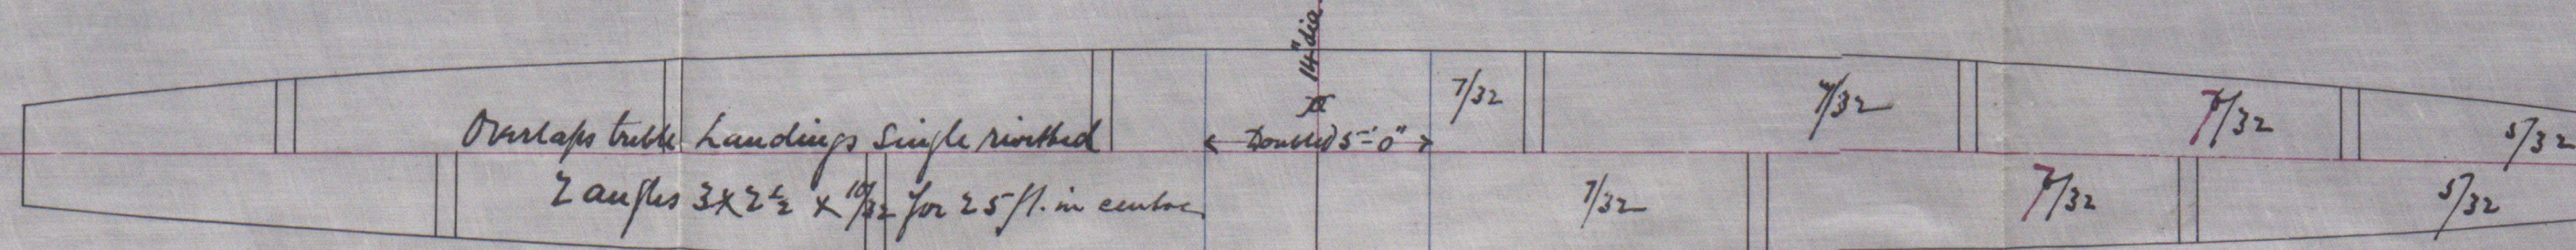


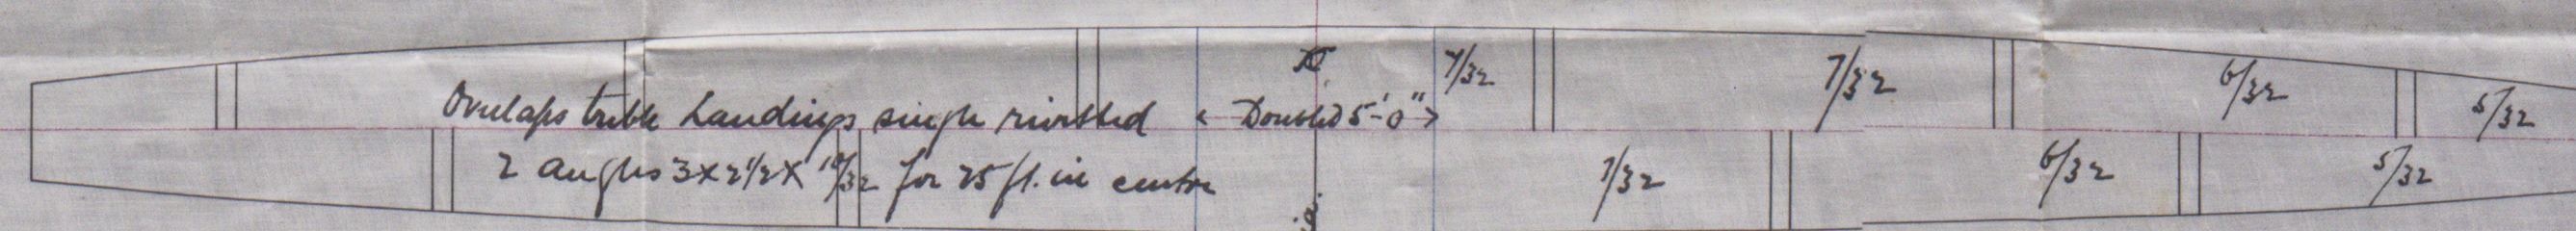


Fore Main Lower Yard 6 1/2 ft. in.

Fore Main Lower Topmast Yard 5 1/4 ft. in.

Fore Main Upper Topmast Yard 5 1/4 ft. in.

11/11/83

GIRK 300-0325