


RECEIVED 23rd JAN. 88

Lt. Blythe

24/1/83.

s.s. Progress

Greenock Report N: 8515

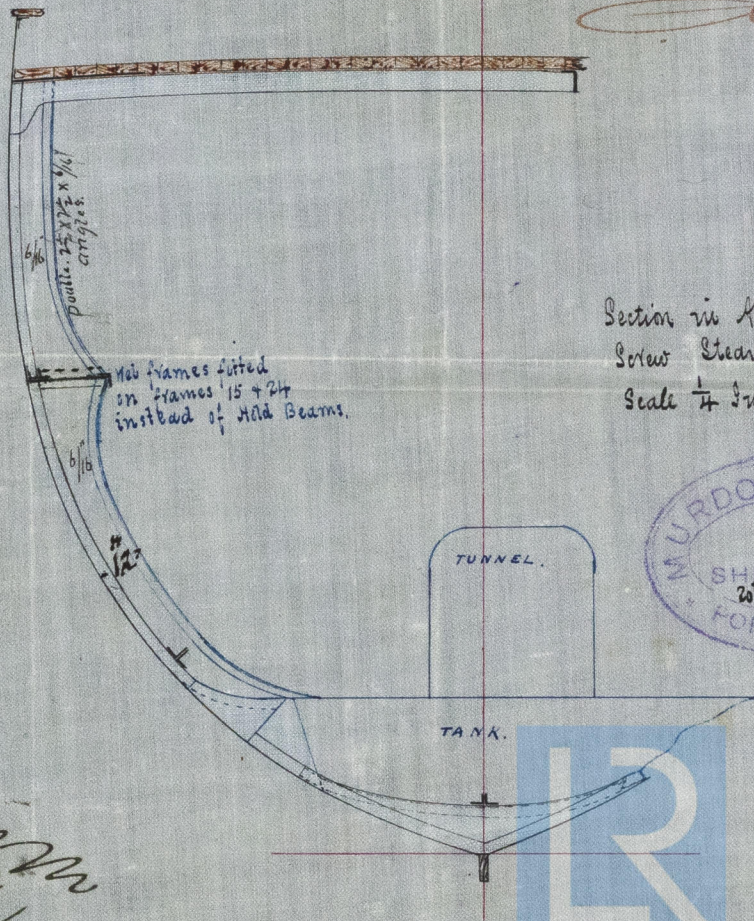

Section in After Hold
Screw Steamer N: 74

Scale $\frac{1}{4}$ Inch = 1 Foot.



1882
23/1/83



© 2019

Lloyd's Register
Foundation

GRK304-0005