


RECEIVED 10 JAN 83  
RECEIVED 18 JAN 83

Let. to Greenock  
11/1/83.  
24/1/83.

S. S. Progress  
Greenock Report No 8515

LONGITUDINAL SECTION  
S. S. No 74.  
Scale 1/2 inch = 1 foot

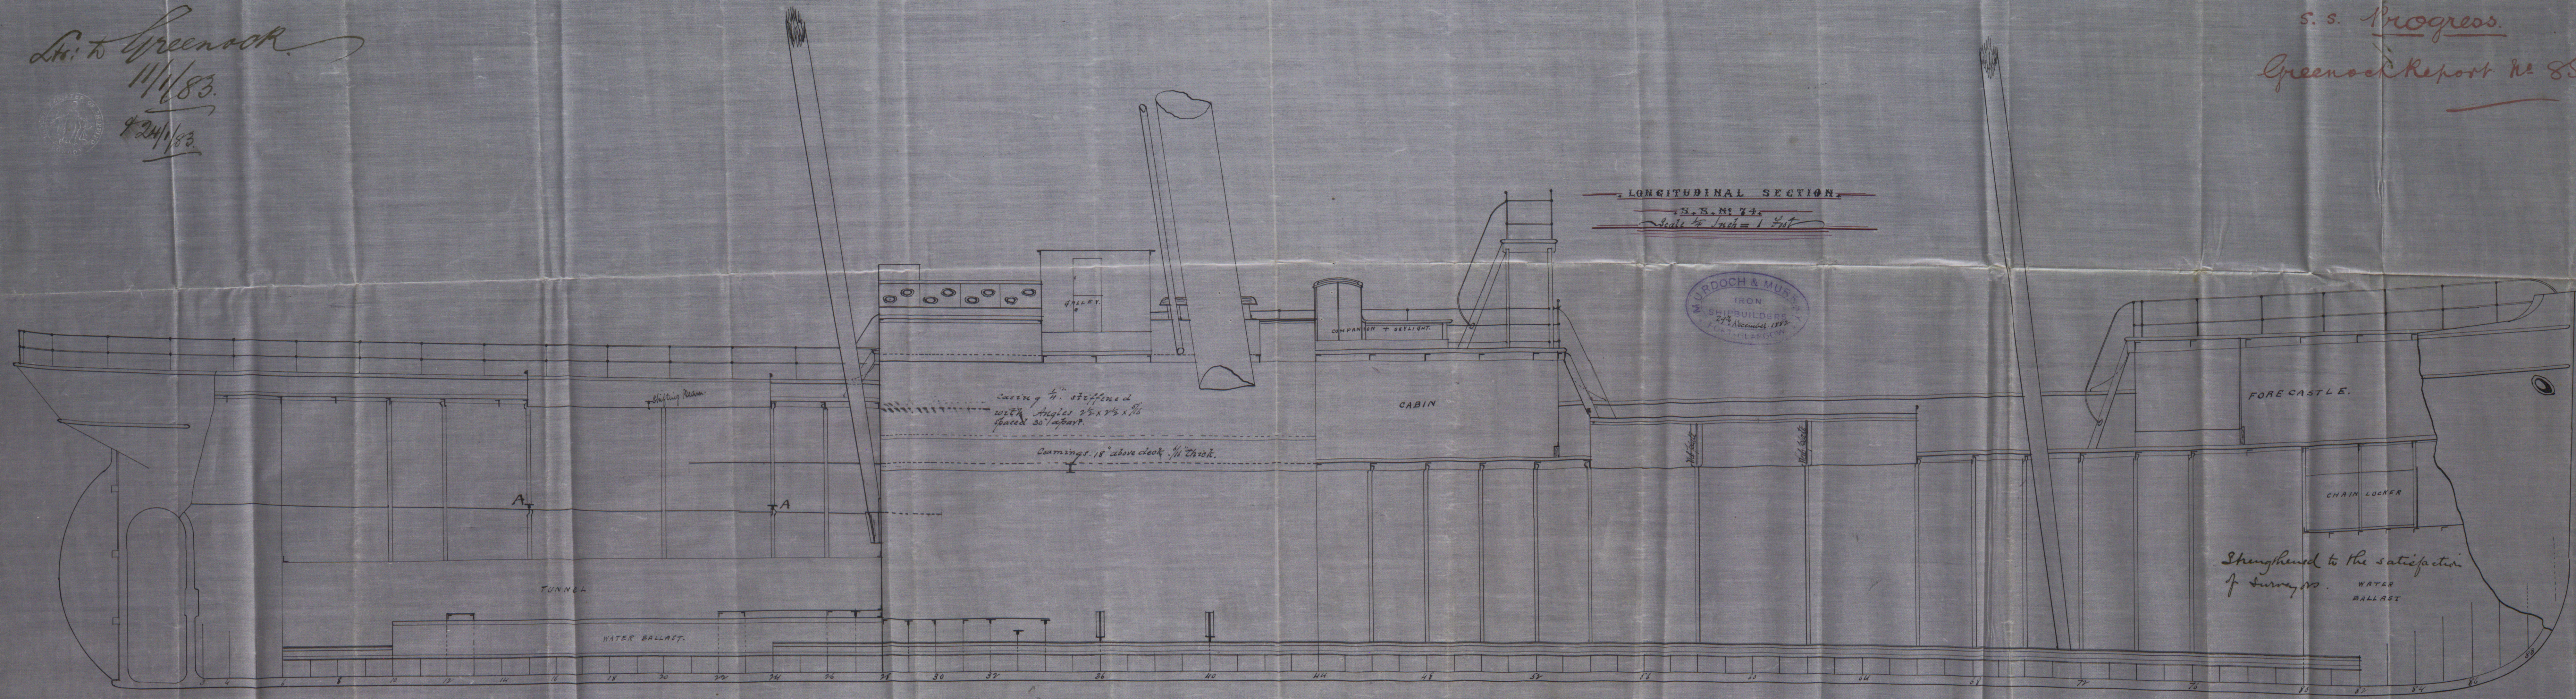

Strengthened to the satisfaction  
of Surveyors.  
WATER  
BALLAST