

S. S. Progress.

Greenock Report ctz 85/5

Dr. to Greenock

83.

424/183

MIDSHIP SECTION

S. S. No 74.

SCALE $\frac{1}{2}$ INCH = 1 FOOT.

CLASS 100 A. RAISED QUARTZ BRIDGE TOP F.C.

| | |
|-------------------------|-------|
| Depth | 13.16 |
| Half Breadth | 11.45 |
| Girth | 21.55 |
| $1\frac{1}{2}$ Numerat. | 46.16 |
| Length | 155.8 |
| | 21222 |

$$\begin{array}{r} 38928 \\ 23080 \\ 23080 \end{array}$$

2nd Numerical: $\frac{4616}{7191-728}$
add $\frac{1}{10^{th}}$ 719.172

Equip. Numeral 7910-900


Breadth to Length 6.7
Depth to Length 11.8

Numerical at Quad. DK. 54. 16.


EQUIPMENT

2 Bower Anchors. $8\frac{1}{4}$ cmt. Ex Stock } Coll^d W^{ts}
1 " " " " " " " " } 23 $\frac{1}{2}$ cmt
1 Stream " " " " " " " " }
1 Kedge " " " " " " " " }
165 Fathoms $1\frac{1}{16}$ Stud Chain Cattle
60 " " $\frac{1}{16}$ Stream Chain.
75 " " $7\frac{1}{2}$ Towline.
90 " " $5\frac{1}{2}$ Hawser.

Note. Scantling for Raised Quat Deck in Red
Reverse frames to hold Beams and Break Stringer alternately.
Frames all to Gunwale of Break. Main Sheer Strake doubled
for 26 feet. and sides of Break. increased to at Break.
Butt Straps of sides of Break. Sheer Strake + Strake next below
to thicker and Heble riveted in way of Break.
Main Stringer to extend 7 frame spaces abaft Break. Quat Dk
Stringer 4 spaces before Break. Hold Stringer overlapping about 16 feet.

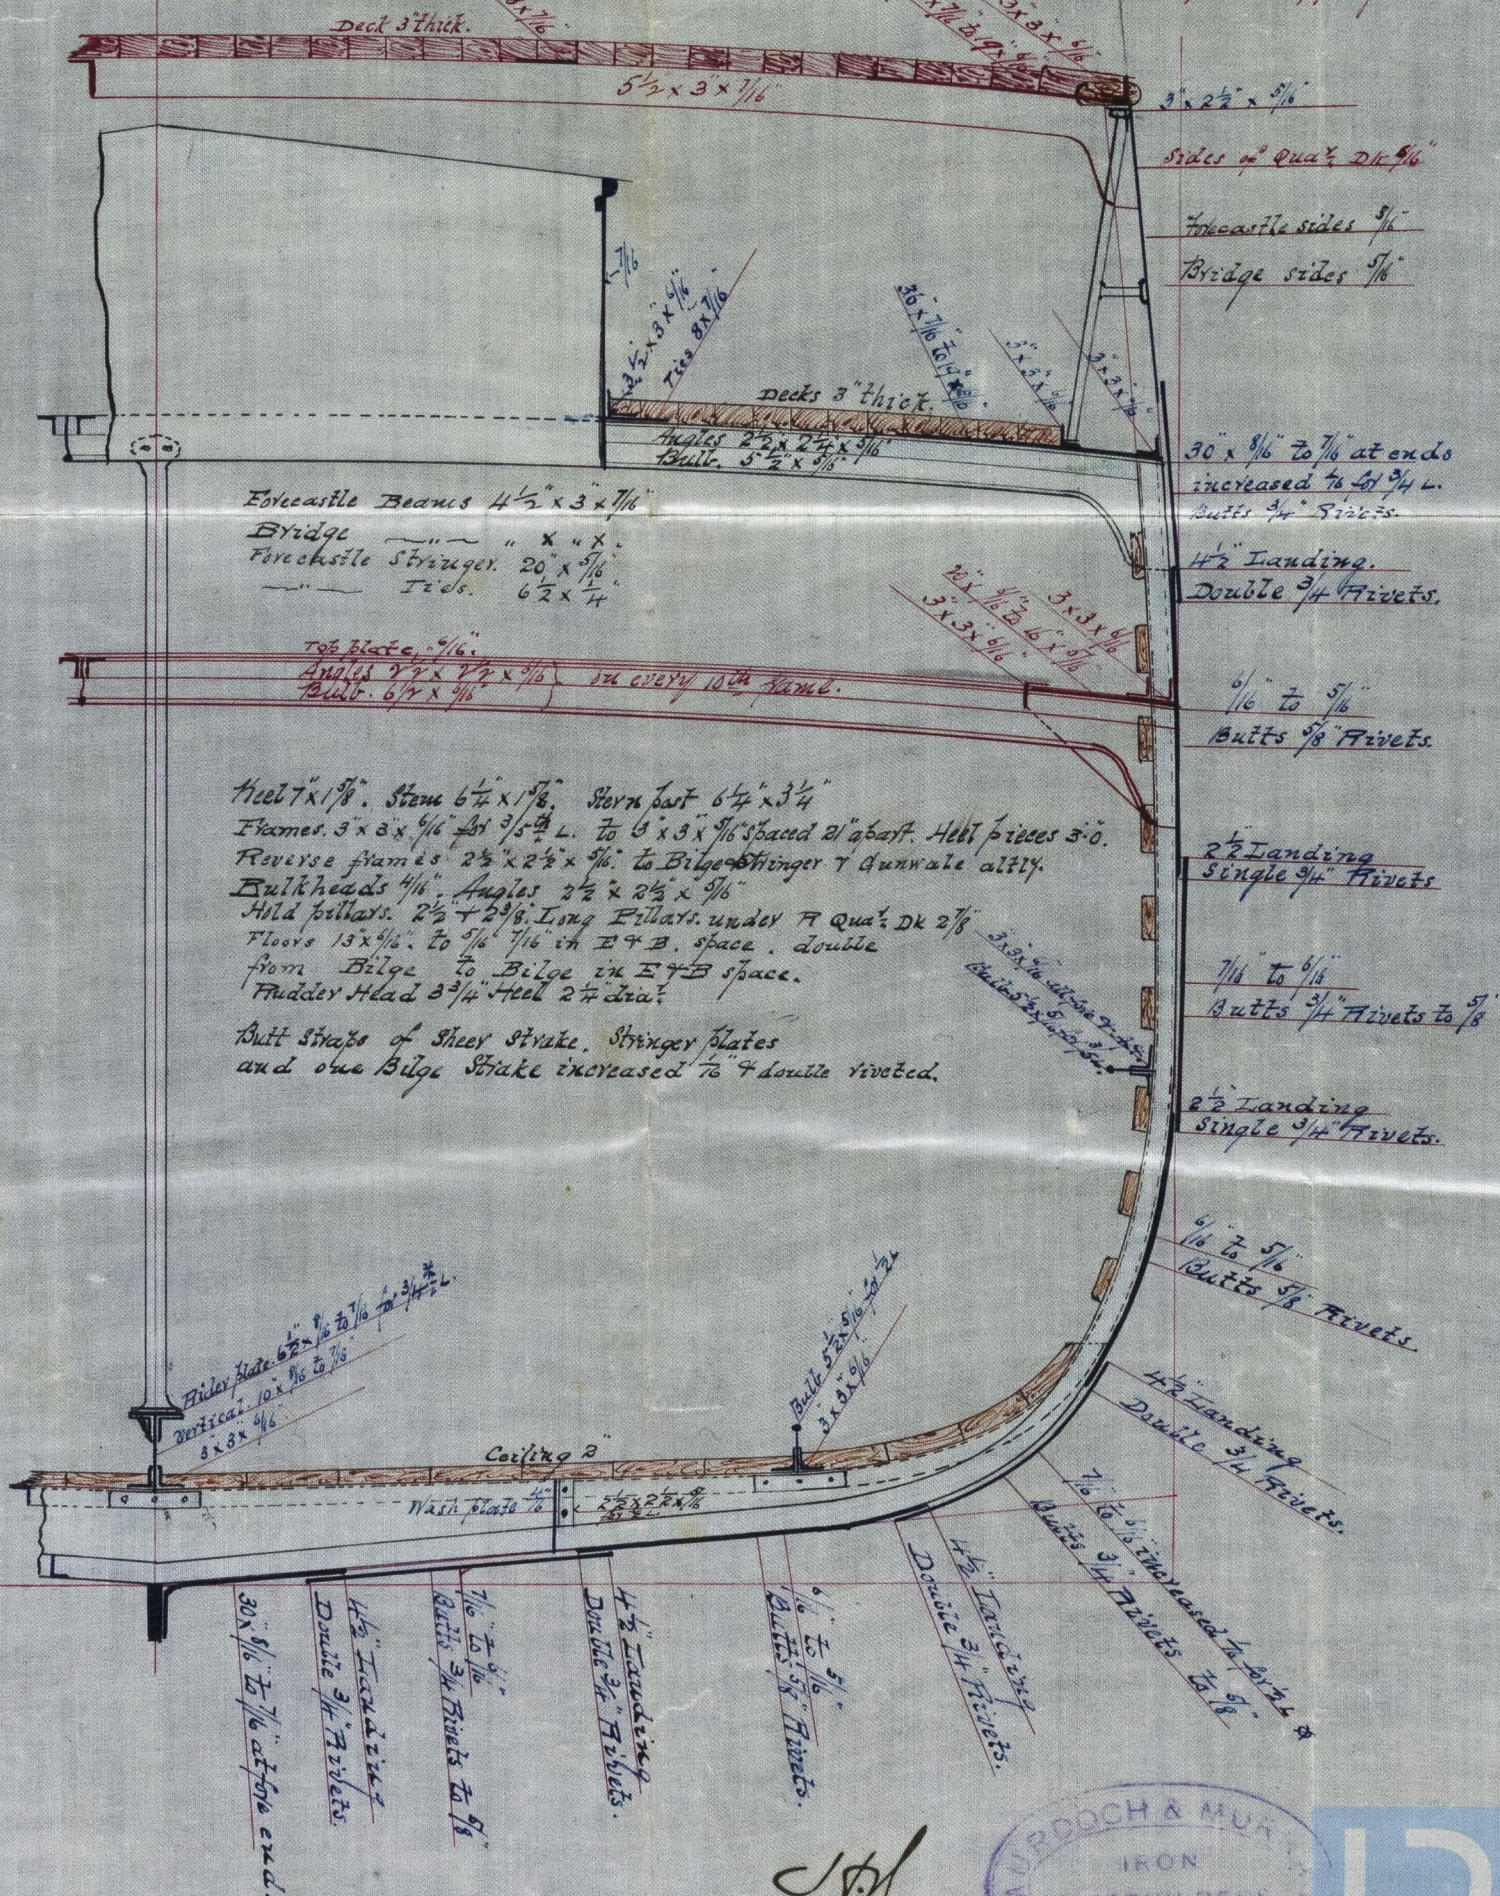

11/183

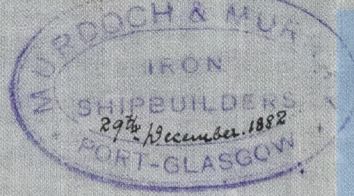

© 2019

Lloyd's Register
Foundation
7/11/2017