




Dr. B. C. M.  
21/12/82

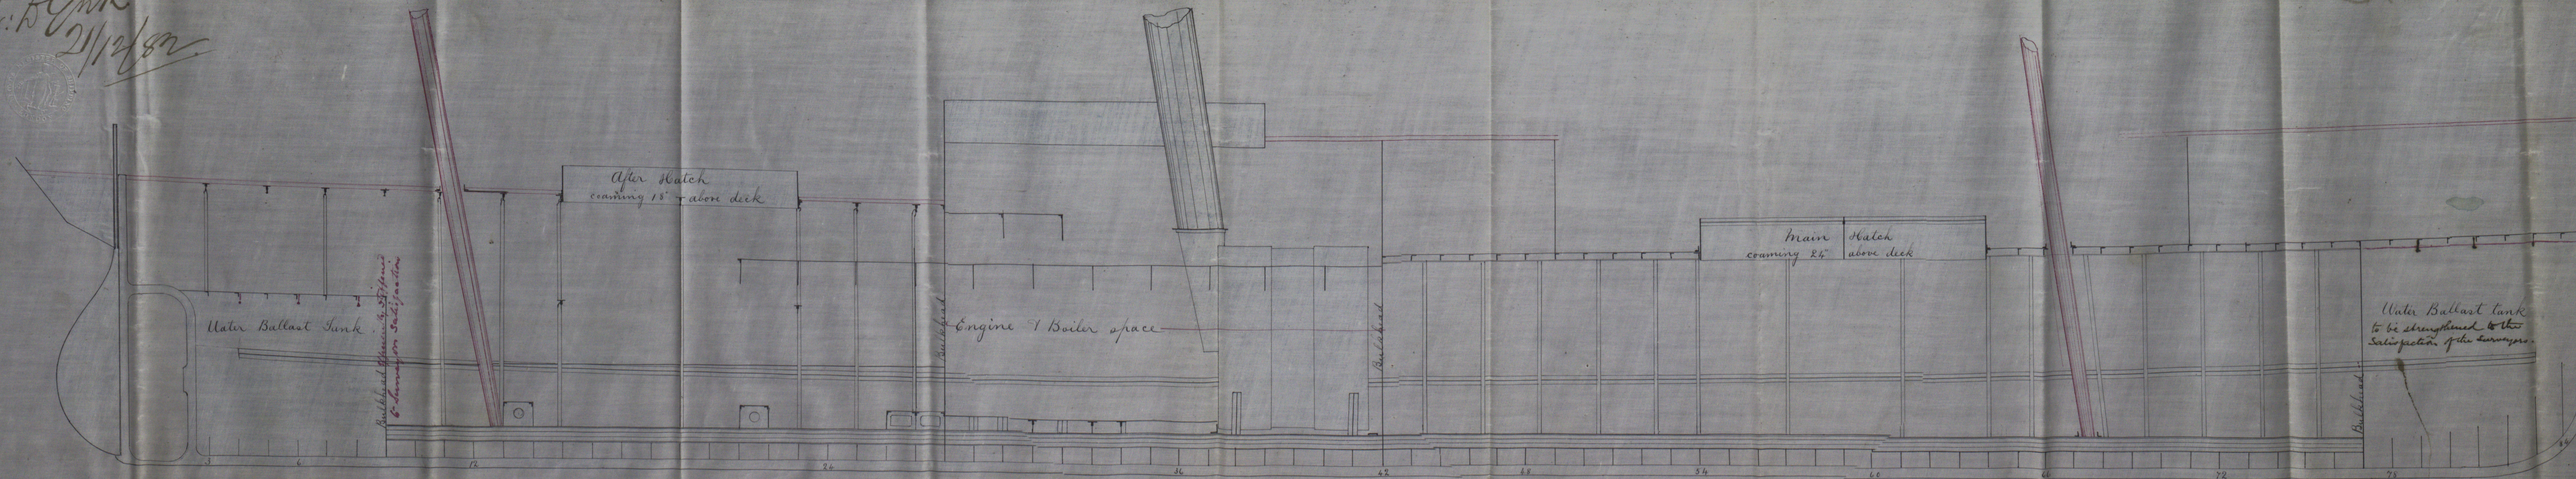

S.S. "Burslem"  
Greenock Report No 8523

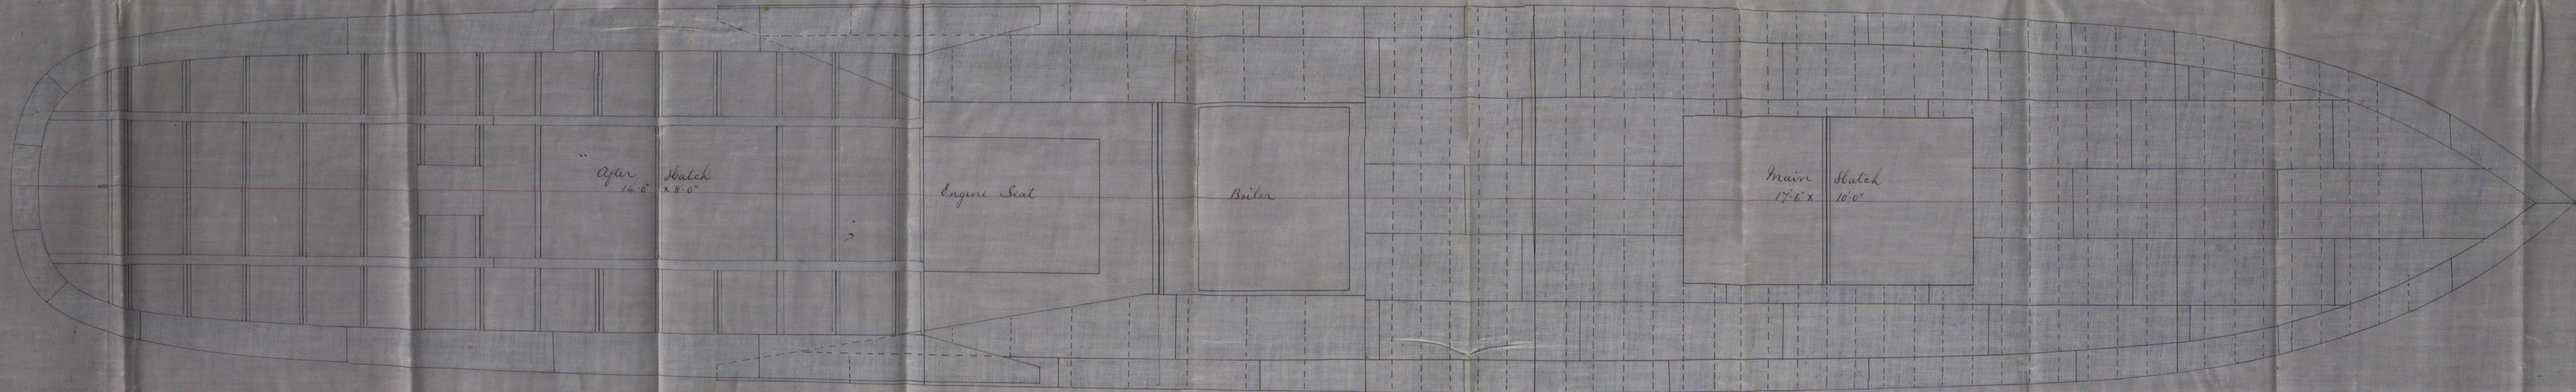

Screw Steamers No 70 & 71.  
Classed 100 A.I.  
Scale 1/4 inch = 1 foot

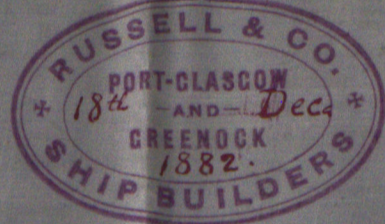

J.H.  
20/12/82