

Lloyd's Register of British and Foreign Shipping.

(Received in the London Office, .)

25 AUG. 83
LONDON

P.

No. ✓

REPORT ON SHIP FORGINGS.

Sir,

I beg leave to report that the undermentioned Forgings, manufactured by The Lameefield Forge Co of Glasgow for the Vessel No. 182, being built by Messrs Blackwood & Gordon of Port Glasgow have been inspected by me in course of being forged and smithed, and found to be, so far as can be seen, sound and efficient

M 23/8/83

Mark on Forging.

Lloyd's
No. <u>✓</u>
<u>G.N</u>

I am, Sir,

Your Obedient Servant,


George Newcomb

The Secretary,
London.

Glasgow

	STERN FRAMES.	RUDDER FRAMES.	STEMS.
Material* - - - -	/	Scrap iron	/
How made - - - -		Forged	
Dimensions - - - -		8 x 6 ³ / ₄ to 7 ¹ / ₂ x 3 ³ / ₄	
Progress on Inspection -		Forged and smithed	
Dates when Inspected -		23.28/5/83. 9.26/6/83. 26/7/83 3.10.17.20/8/83.	

SKETCHES OF FRAMES SHEWING POSITION AND DESCRIPTION OF WELDS.

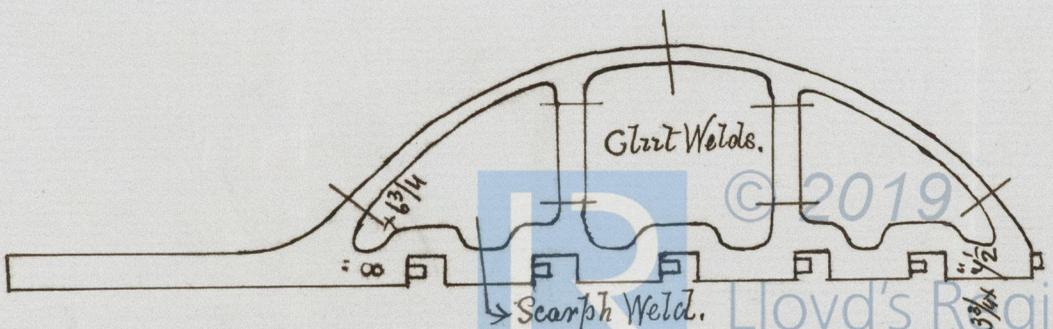

* If of iron, state whether scrap or puddled iron.