


drojuk
1575783


Thickness of shell plates	$\frac{1}{2} \text{ or } \frac{1}{32}$
do of furnace do	$\frac{7}{16}$
do of back & front (bottom)	$\frac{1}{2}$ "
do of do & do top	$\frac{3}{8}$ "

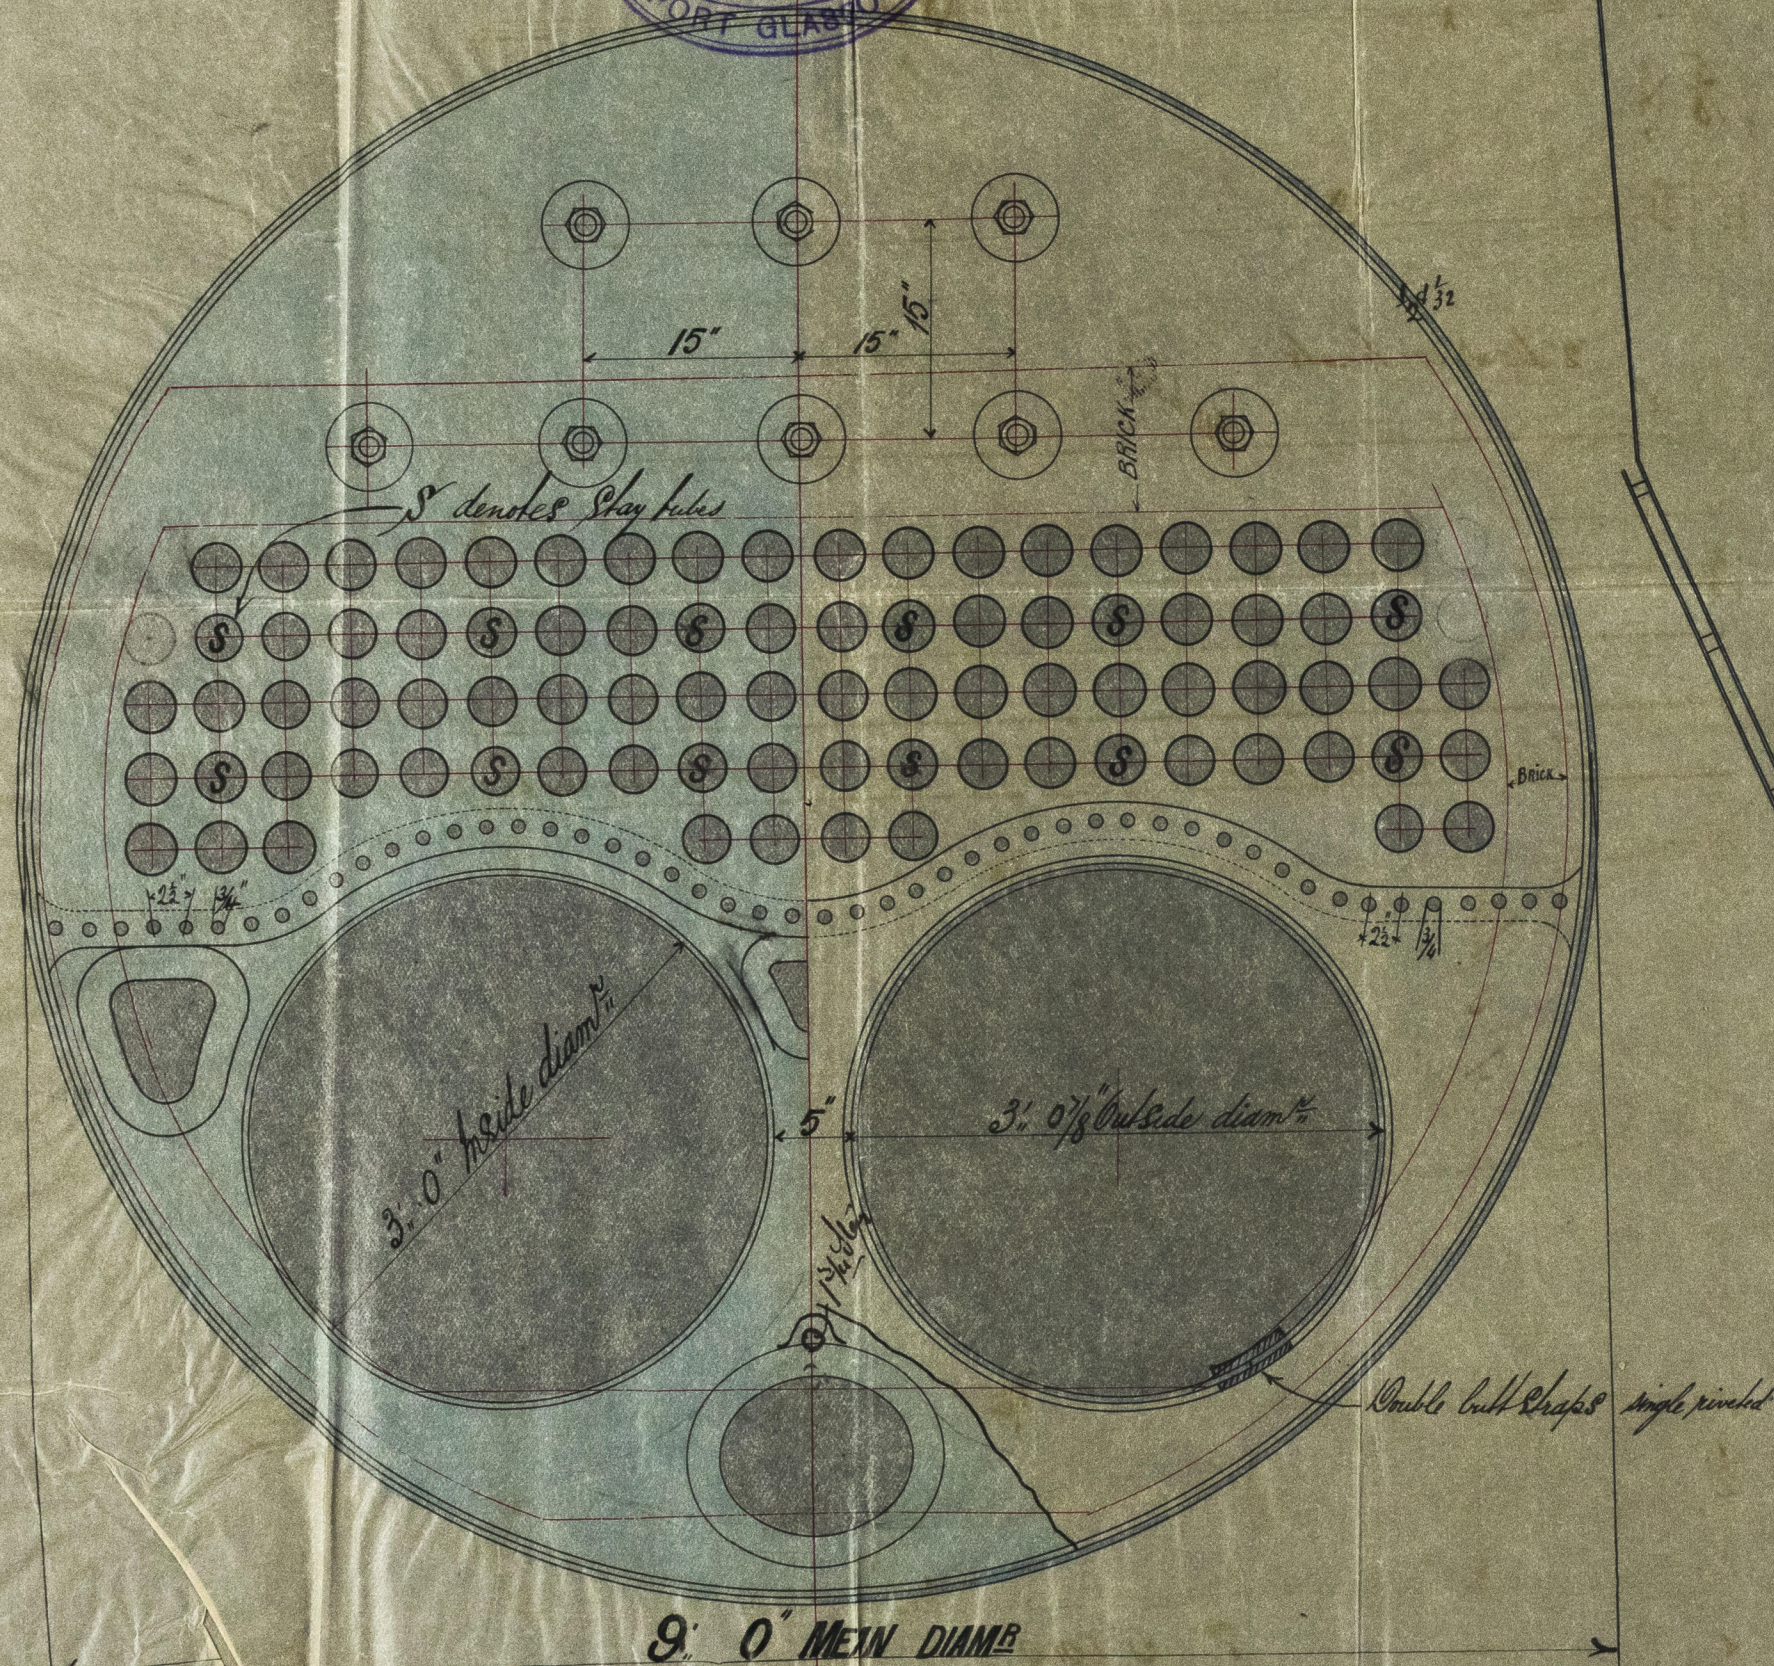

8.8. Spina, Greenock Report № 8556

LLOYD'S REQUIREMENTS
60 LBS WORKING PRESSURE.
IRON PLATE.

mm
15-5-83

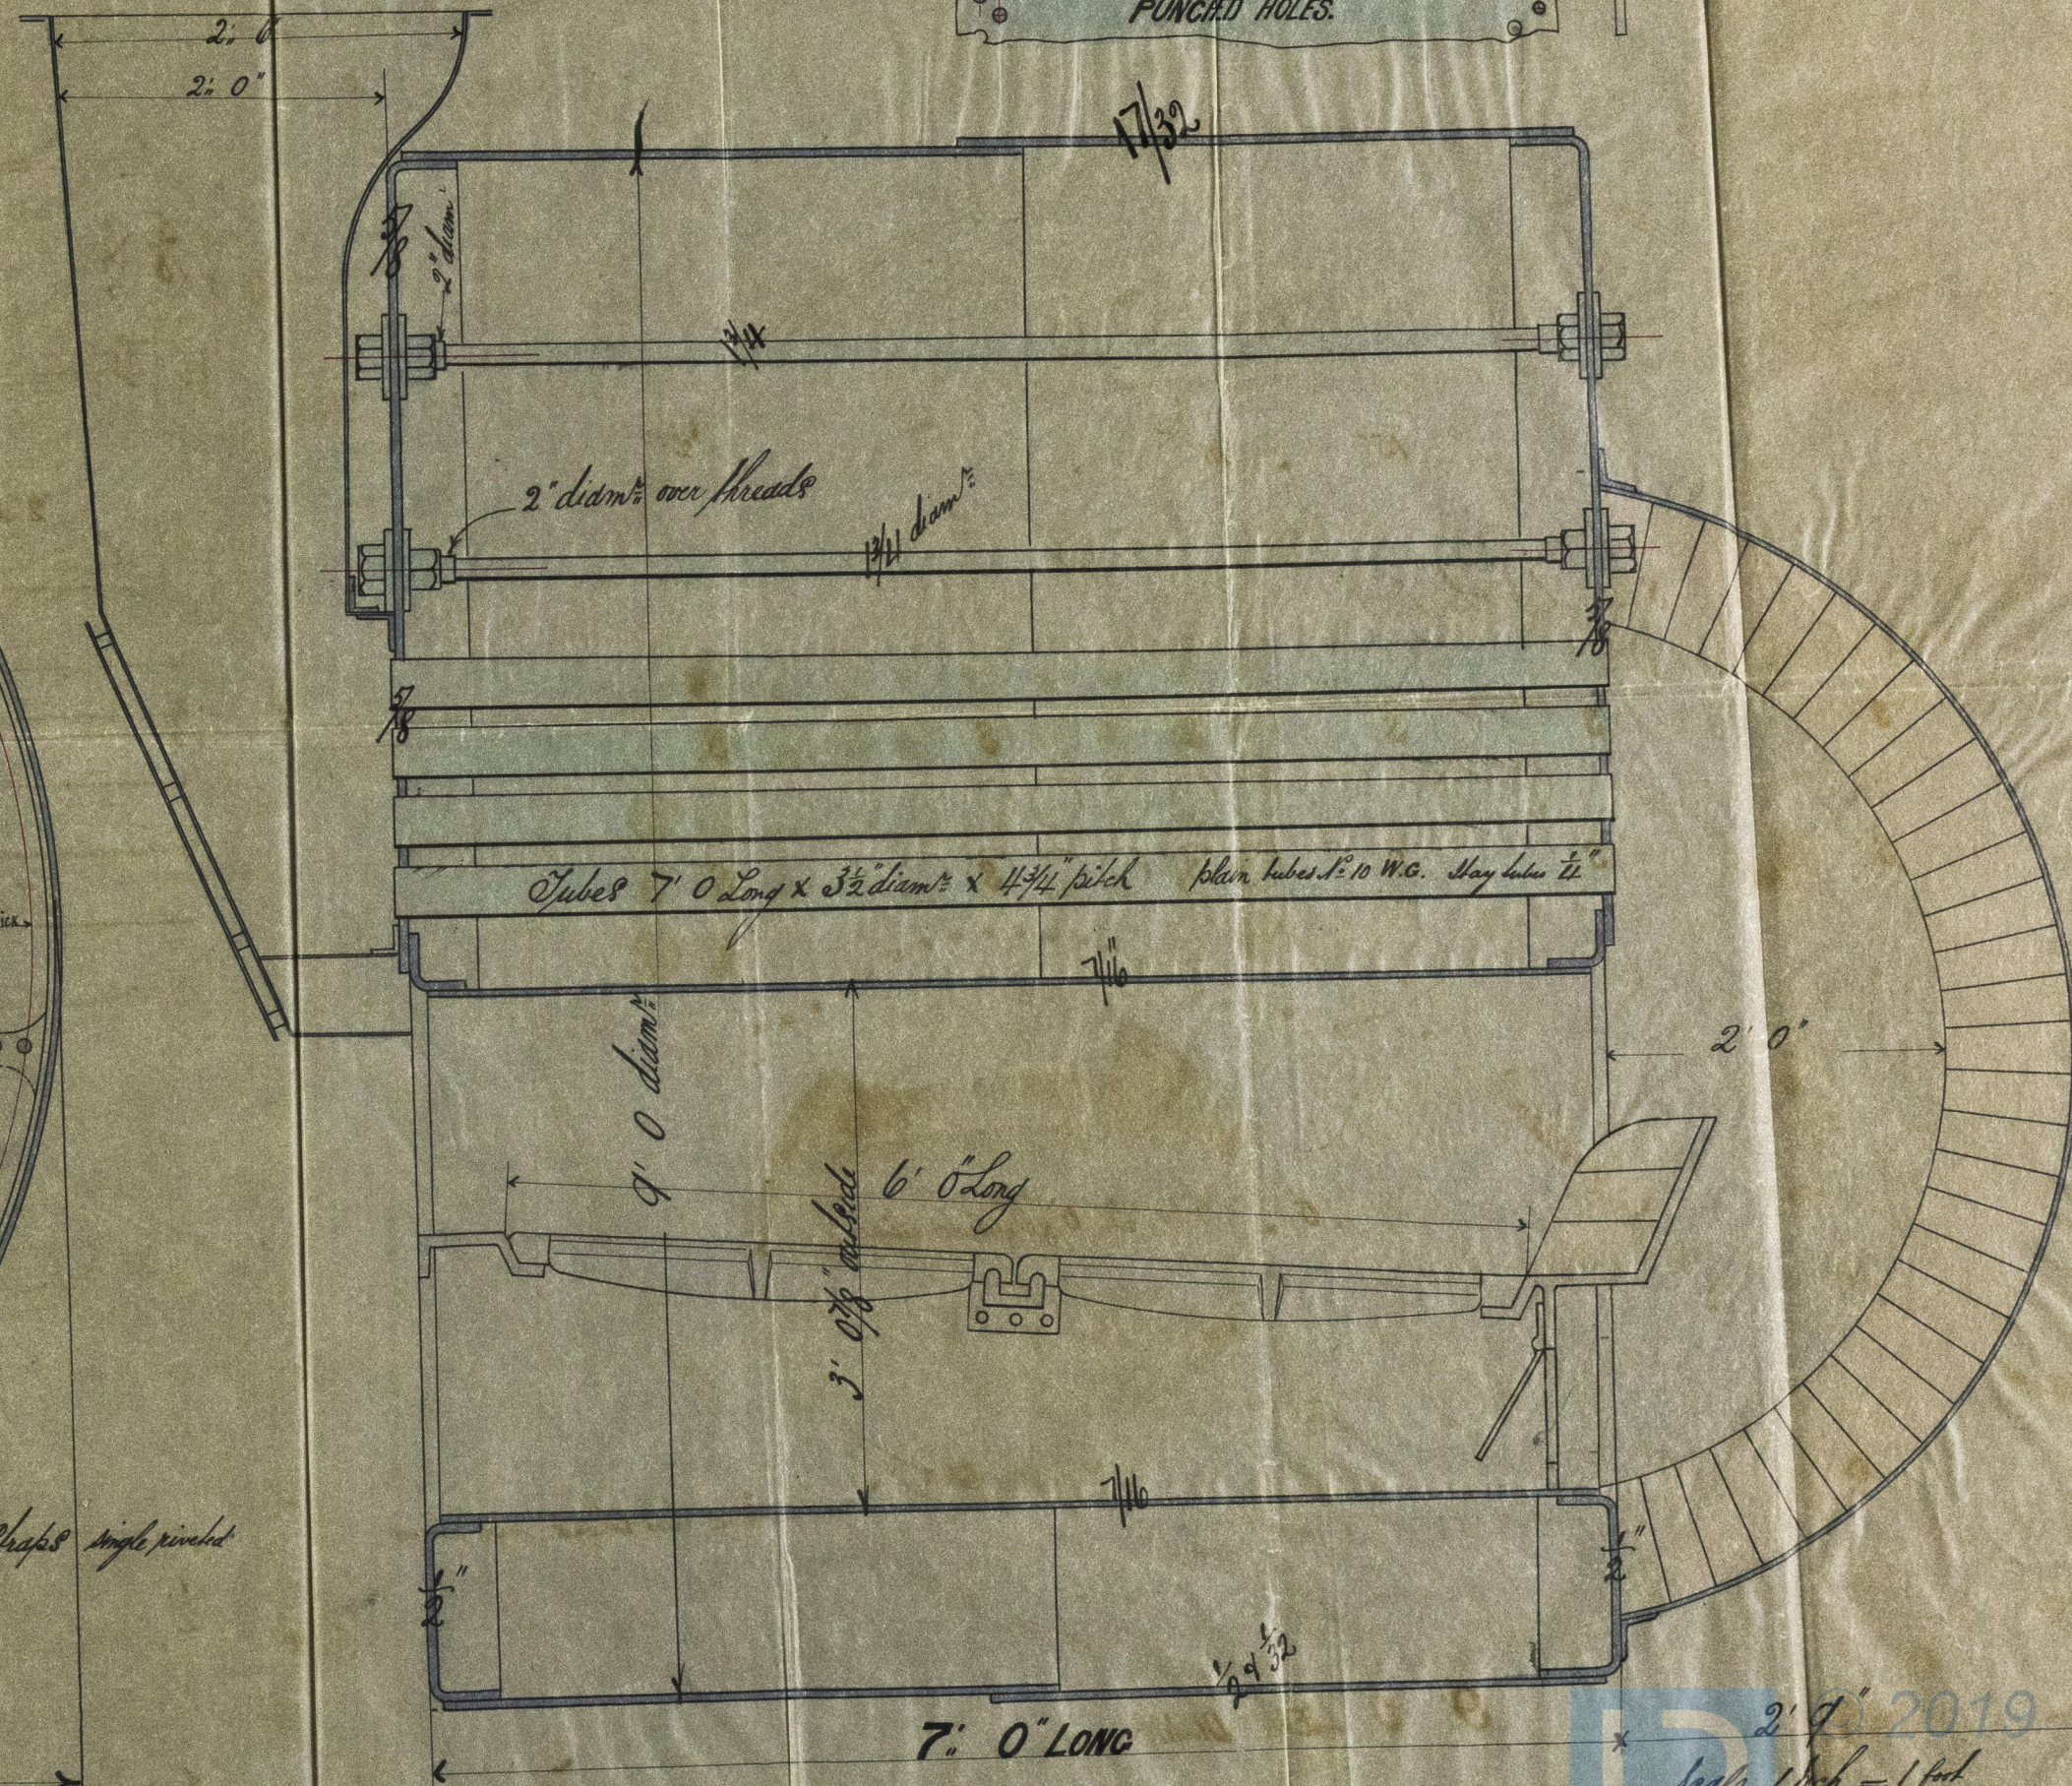

2' 7"
Scale 1 inch = 1 foot

674301-0131