

# Lloyd's Register of British and Foreign Shipping.

(Received in the London Office,



P.

No. 4

## REPORT ON SHIP FORGINGS.

Sir,  
 I beg leave to report that the undermentioned Forgings, manufactured by  
*Messrs J & R. McIntyre & Co* of *Dalmuir*  
 for the Vessel No. *195*, being built by *Messrs R. Duncan & Co*  
 of *Port Glasgow* have been inspected by me in course  
 of being forged and smithed, and found to be, so far as can be seen, *sound and efficient*

*M 29/10/83*

Mark on Forging.

Lloyd's  
 No. 4  
 G.N

I am, Sir,

Your Obedient Servant,


*George Newcomb*

The Secretary,  
 London.

*Glasgow*

|                        | STERN FRAMES. | RUDDER FRAMES.                                | STEMS. |
|------------------------|---------------|-----------------------------------------------|--------|
| Material*              |               | <i>Scrap iron</i>                             |        |
| How made               |               | <i>Forged</i>                                 |        |
| Dimensions             |               | <i>6 7/8 to 3 3/4</i>                         |        |
| Progress on Inspection |               | <i>Forged and smithed</i>                     |        |
| Dates when Inspected   |               | <i>17.23.31/8/83. 4.25/9/83. 19.22/10/83.</i> |        |

SKETCHES OF FRAMES SHEWING POSITION AND DESCRIPTION OF WELDS.

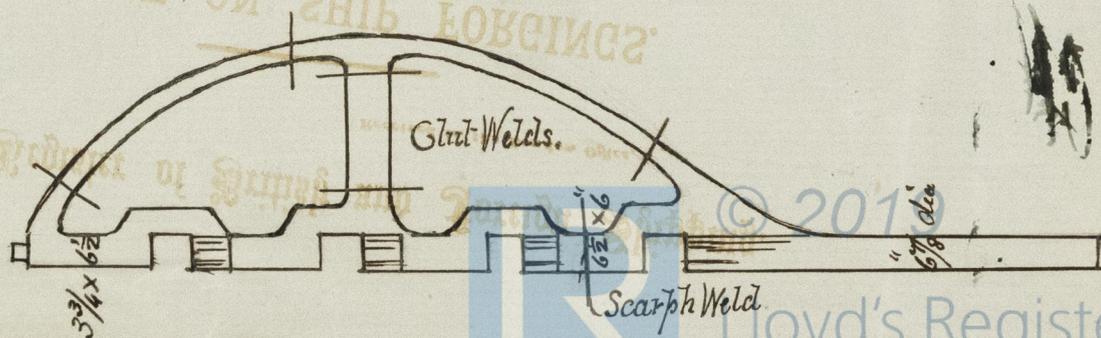

\* If of iron, state whether scrap or puddled iron.