

Lloyd's Register of British and Foreign Shipping.

(Received in the London Office, RECEIVED 11b MAY, 83)

P.

No. 4

REPORT ON SHIP FORGINGS.

Sir,

I beg leave to report that the undermentioned Forgings, manufactured by Messrs J & R McIntyre of Dalmuir for the Vessel No. 195, being built by Messrs R. Duncan & Co of Port Glasgow, have been inspected by me in course of being forged and smithed, and found to be, so far as can be seen, sound and efficient

Mark on Forging.

Lloyd's

No. 4

G.N

The Secretary,
London.

I am, Sir,


Your Obedient Servant,

George Newcomb
Glasgow

	STERN FRAMES.	RUDDER FRAMES.	STEMS & Keel bars
Material* - - - -	<u>Scrap iron</u>	/	<u>Scrap iron</u>
How made - - - -	<u>Forged</u>		<u>Forged</u>
Dimensions - - - -	<u>9 x 2 1/2</u>		<u>12 x 2</u>
Progress on Inspection -	<u>Forged & smithed</u>		<u>Forged & completed</u>
Dates when Inspected -	<u>30/1/83. 1.5. 7/3/83.</u>		<u>2.17/4/83. 1/5/83.</u>

SKETCHES OF FRAMES SHEWING POSITION AND DESCRIPTION OF WELDS.

m 10/5/83

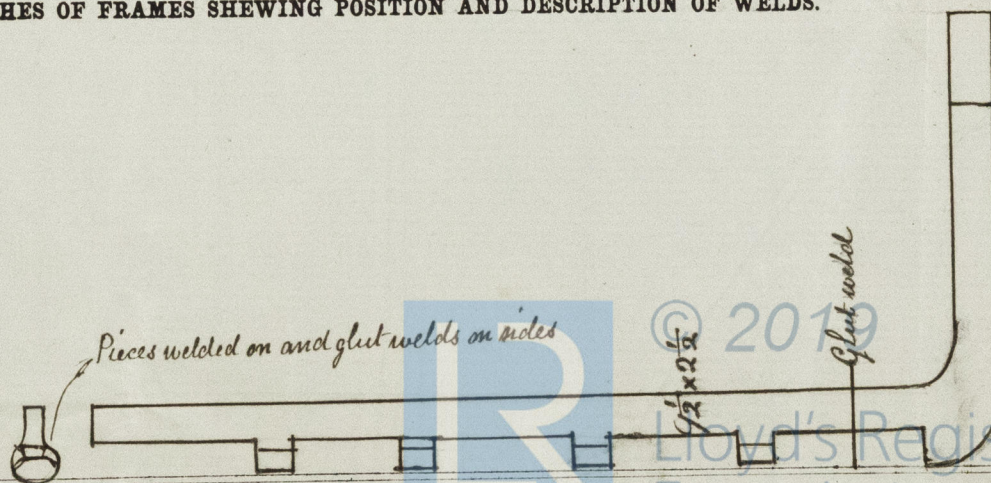

* If of iron, state whether scrap or puddled iron.