

RECEIVED  
NOV 1883


Dr. D. G. P.  
7/11/83.

Profile of N. 16 S.S. "Bochard"  
Showing position of Water Ports  
1" Scale

260 total length  
Gun 7 1/2 length

S.S. Bochard  
Greenock Report etc 858

Section in way of  
Water Port  
1" Scale

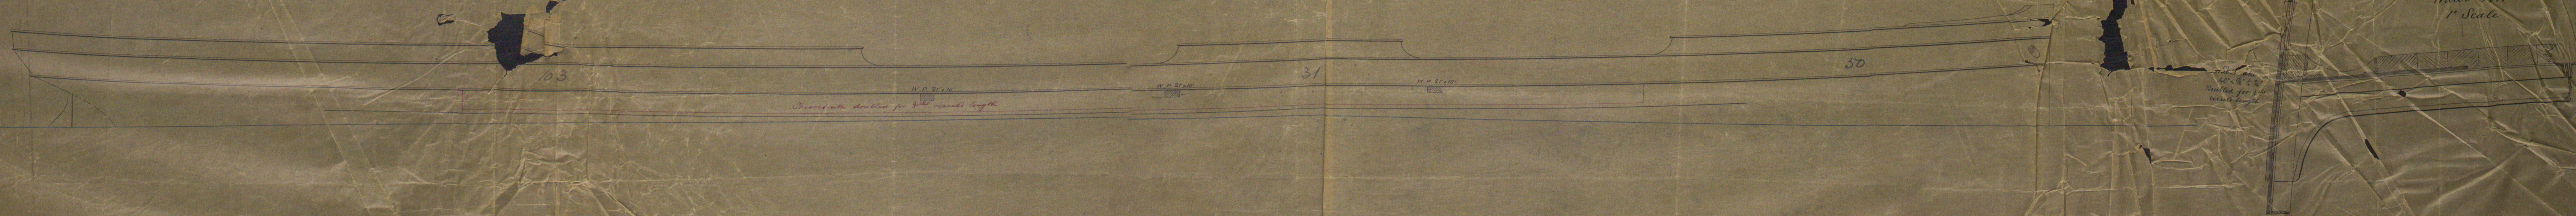

1883  
7/11/83



