


LONDON REGISTER OF SHIPPING
 13 SEP. 83
 LONDON
 RECEIVED
 6 NOV. 83
 SHIP DRAWING OFFICE
 DAVID J. DUNLOP & CO.,
 100, WARD, PORT-GLASGOW.
 Sent out 6th March 1883

Lt. to Capt.
 12/3/83.
 14/9/83.
 7/11/83.

Longitudinal Section S.S. No 168
 Scale 1/8" inch = 1 foot

s.s. Pochard
 Greenock Report No. 8584

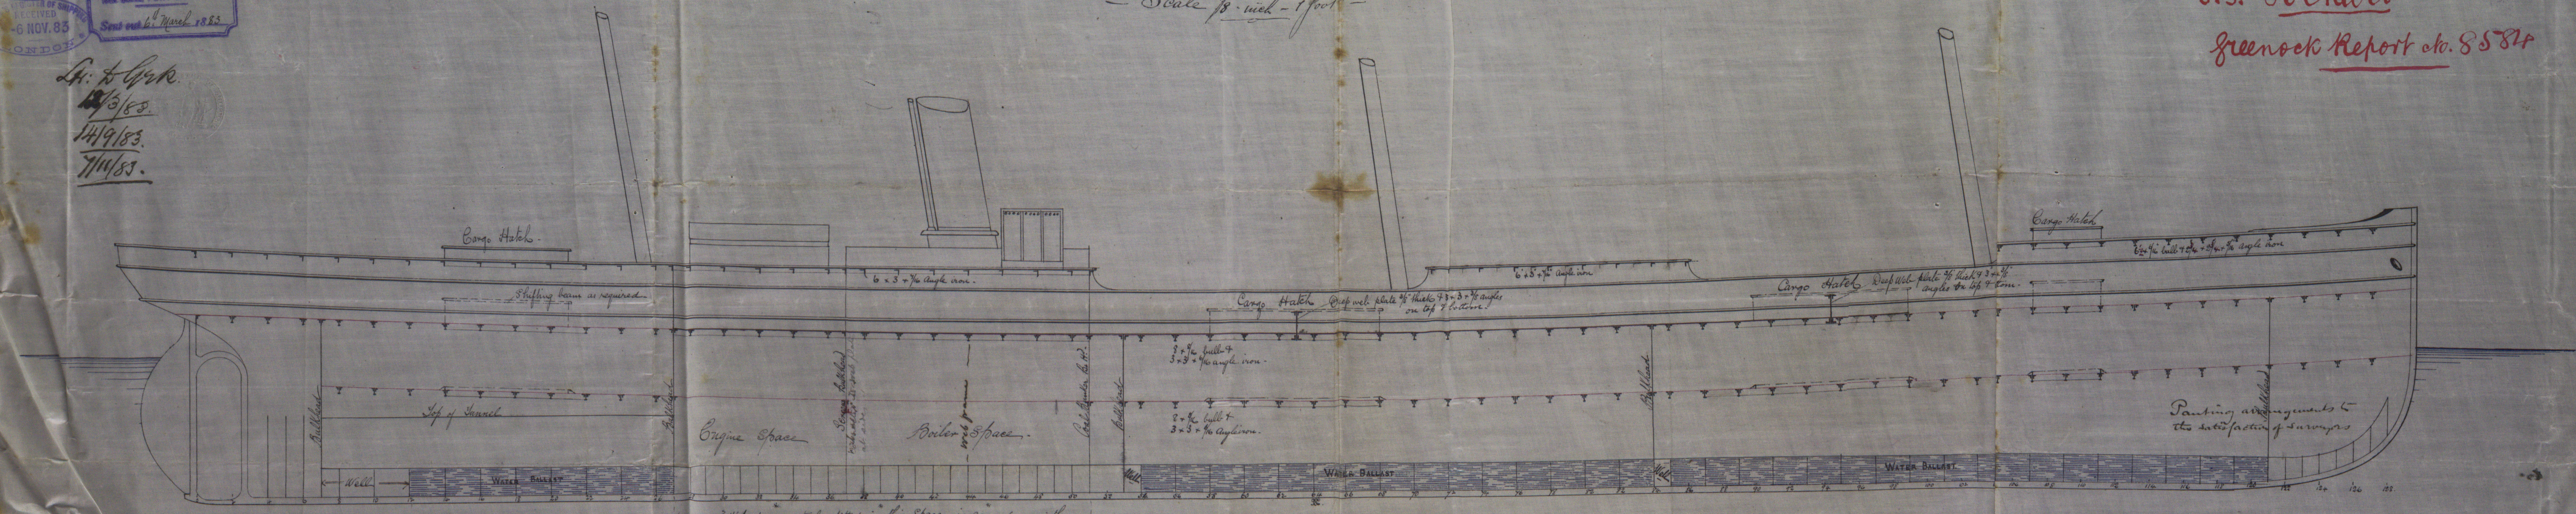

3 Web frames to be fitted in this space in accordance with rules
 * See Note on Tnd. Sec.

107
 13/83

DAVID J. DUNLOP & CO
 ENGINEERS & SHIPBUILDERS
 PORT GLASGOW.