


S.S. Cassia and  
S.S. Claudia  
Greenock

Report nos 8585 +  
no 8651

GR2301-0193

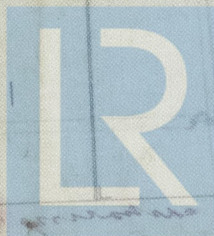

© 2019


Lloyd's Register  
Foundation



RECEIVED 188 FEB. 28.

See 24th p.  
17/2/83.

S.S. Cassia and "Claudia"  
Greenock Report No. 8585+8631

 

LONGITUDINAL SECTION  
S.S. No. 73 + 76  
Scale 1/4 inch = 1 foot.



CHAIN LOCKER  
WATER BALLAST  
Satisfactory arrangement to the Surveyor