

Midship Section of Ship No. 196

Ltr: to Gmk.
18/12/82.

Dimensions etc

$$243.5 \times 38.84 \times 25.45$$

"Skelmorlie?"


Link Report

Vol. 8595 (F. Bourq)

48602 (first entry)

To Class 2041 @ Lloyds

Numerals	Proportions
$\frac{1}{2}$ Girth 38.60	Breadths in
$\frac{1}{2}$ Breadth 19.42	Depth "
Depth 25.45	
83.47 = 1st Num!	
243.5	
41735	
25041	
32388	
16694	
20324945 = 2nd Num!	
+ 1/5 1354.996	
21679.941 = E. Num!	

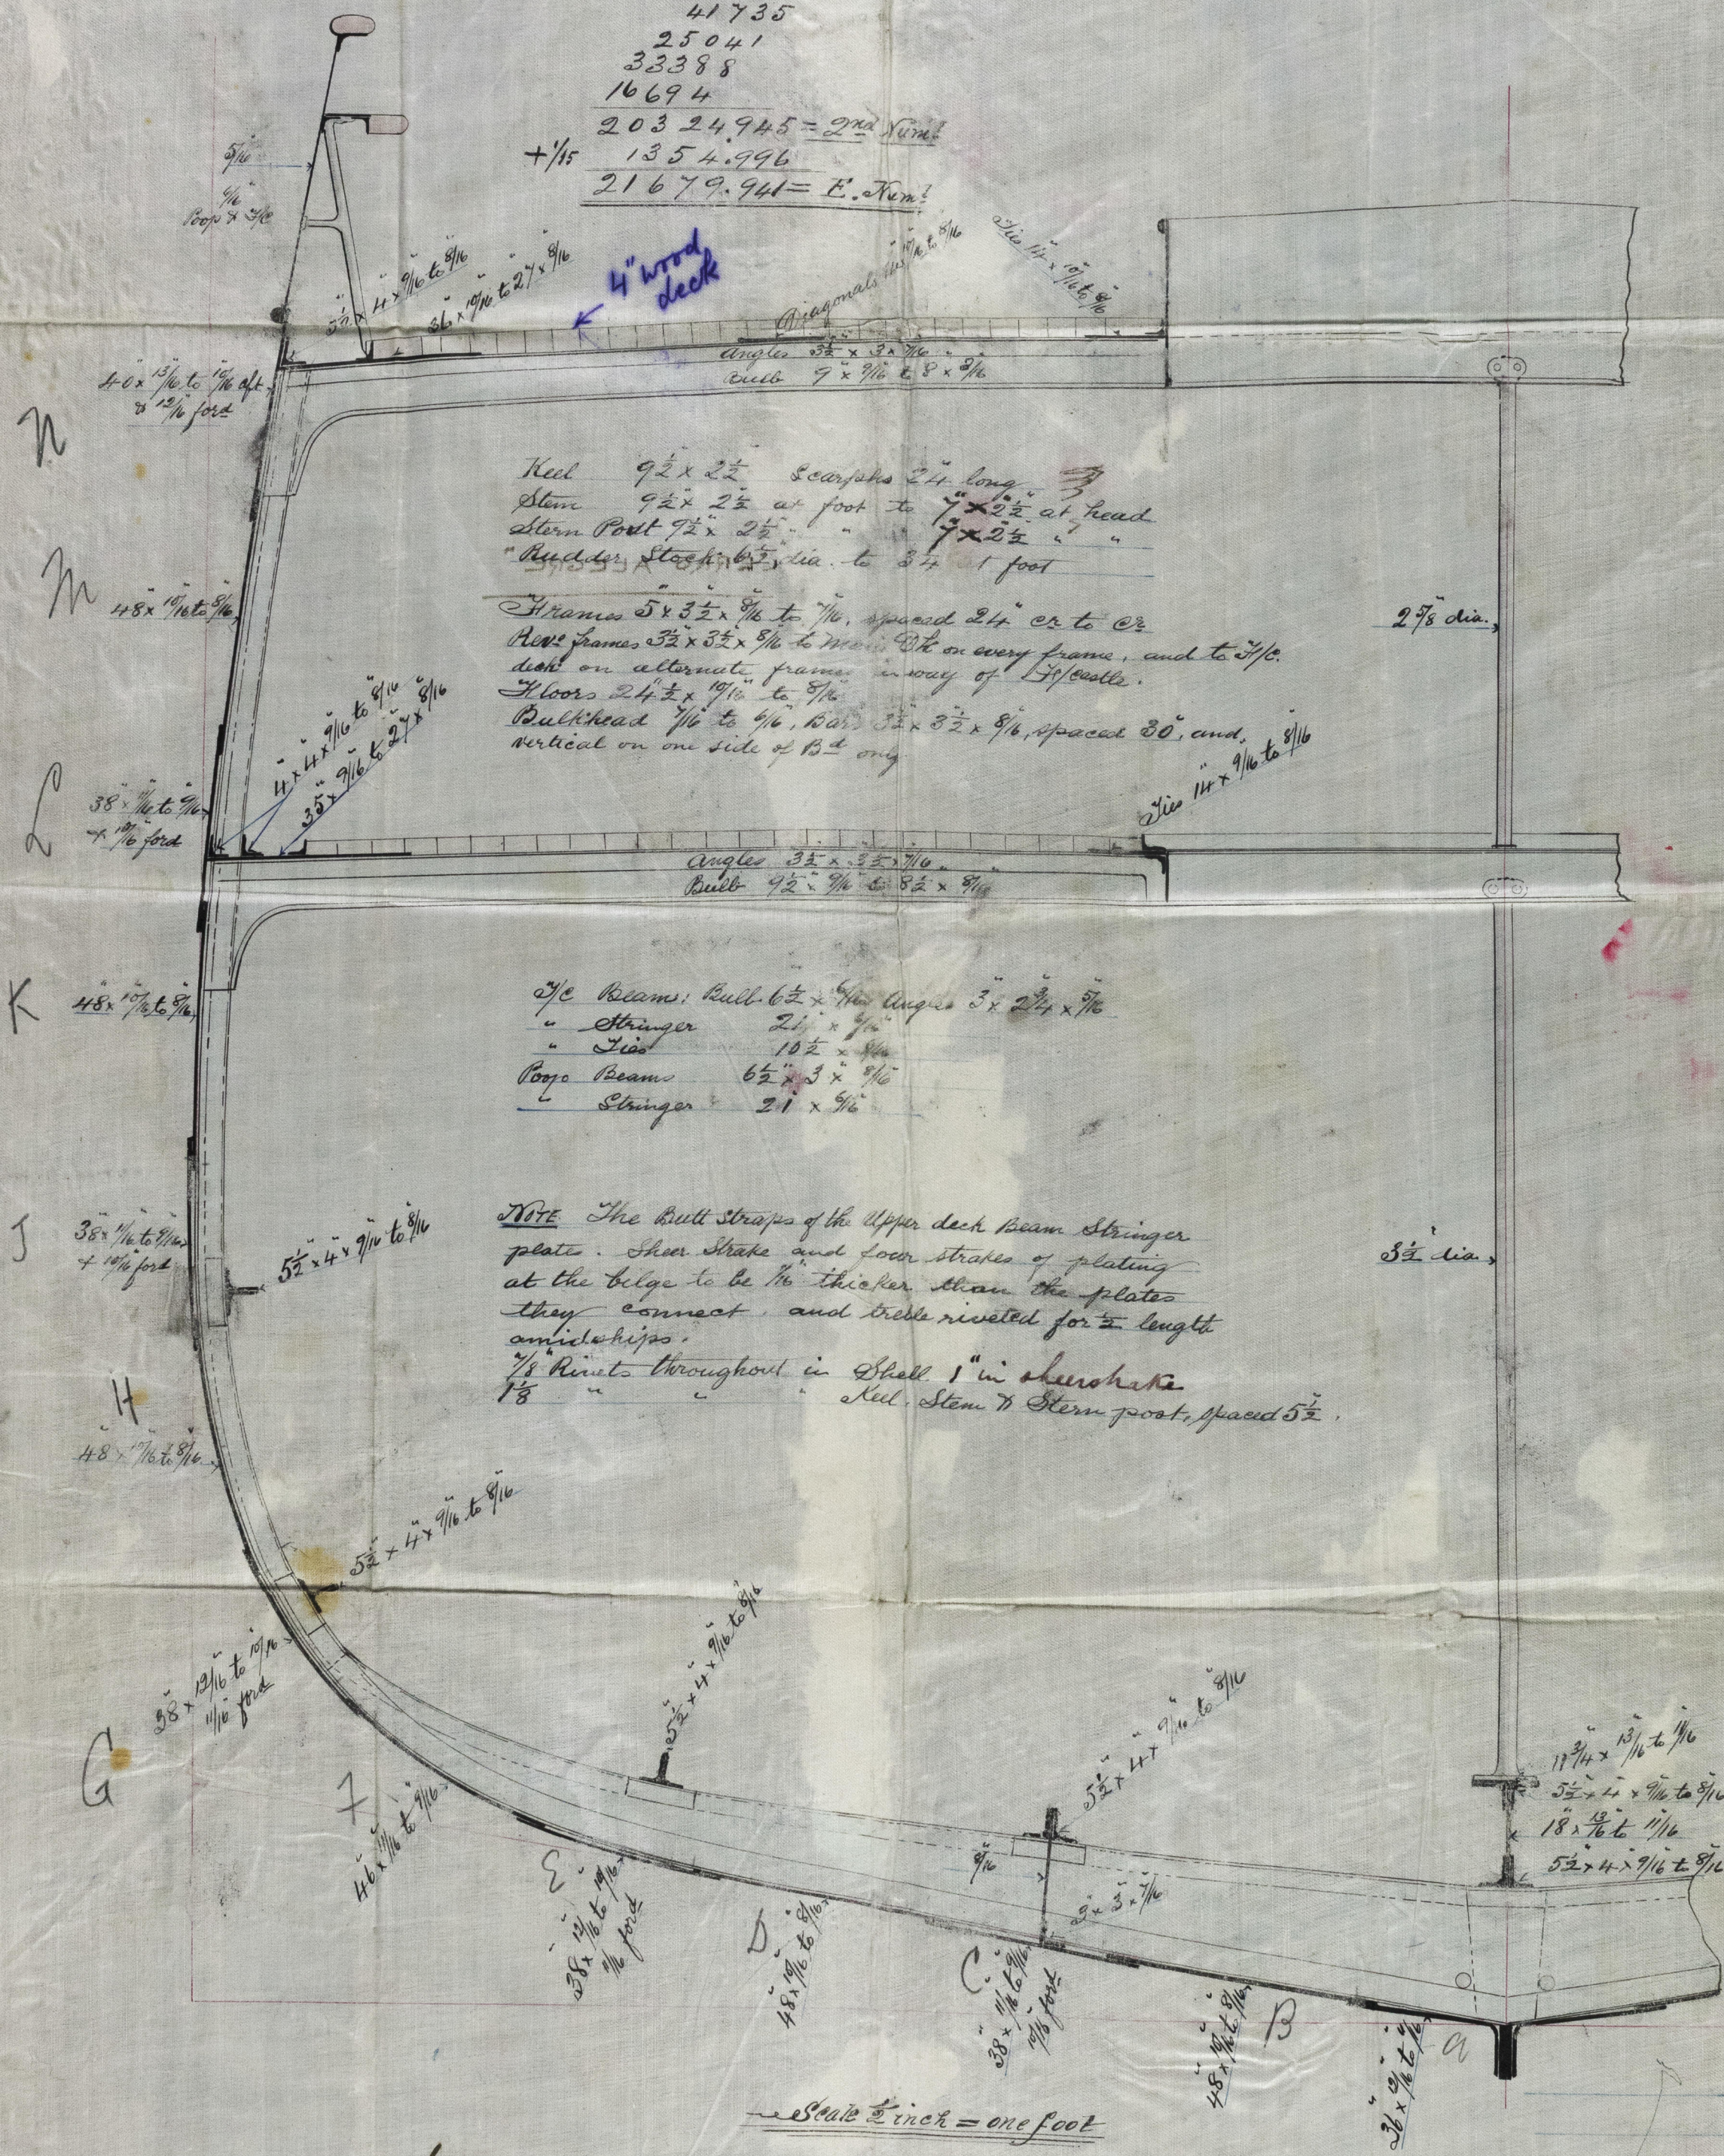

Scale 2 inch = one foot

ROBERT DUNCAN & CO
SHED BUILDERS
PORT GLASGOW
12.12.82.

Stachanov

Stachanov

1928

1928

Stachanov

CERRO ALEGRE

Am301-0264



© 2019

Lloyd's Register
Foundation