


Dr. H. Gr. R.
31/3/83.

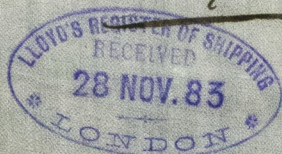

SCALE $\frac{1}{2}$ INCH = 1 FOOT

Class 100 A.


s. s. "Fortescue"
Greenock Report no. 8703.

Half Breadth	16.45	<u>Equipment</u>	
Half Girth	30.3	2 Bow & Arrows	21 cnt. In stock } Collecting no.
Depth	17.0	1 "	18 " " " " } 60 cnt.
First Numeral	63.75	1 Stream	7 1/2 " " " "
Length	223.8	1 Hedge	3 1/2 " " " "
	510.00	1 "	1 3/4 " " " "
	191.25	240 Fathoms	1 1/2 " Stud Chain Cable
	127.50	75 "	1 1/2 " Stream Chain
	127.50	40 "	10 " Towline
Second Numeral	142.67.250	40 "	8 " Trawl
add 4th	142.67.250	40 "	5 1/2 " Trawl
Equip Numeral	15643.975	Note. Scantling for Flues & Qu? Deck. S. Ho?	

— Proportions.
Breadth to Length—
Depth to Length—
Numerical at Quad. Deck.

Note. Scumming in House Que? Deck, shown in Red.
Frames all of Gunwale of Break
Reverse Frames to Head Stringer & Bleak Stringer alternately
Sheer strake doubled for 30 feet in way of Break.
Stakes of Break increases to in way of Break to
Butt Joints of Stakes of Break. Bleak Stringer and Strake
next below to Strake and cable fitted in way of Break.
Main Stringer to extend 7 frame spaces aft of Bleak.
Bleak Stringer & frame 5 was before Bleak and
Hull Stringer overlapping about 16 feet

23rd March - 83

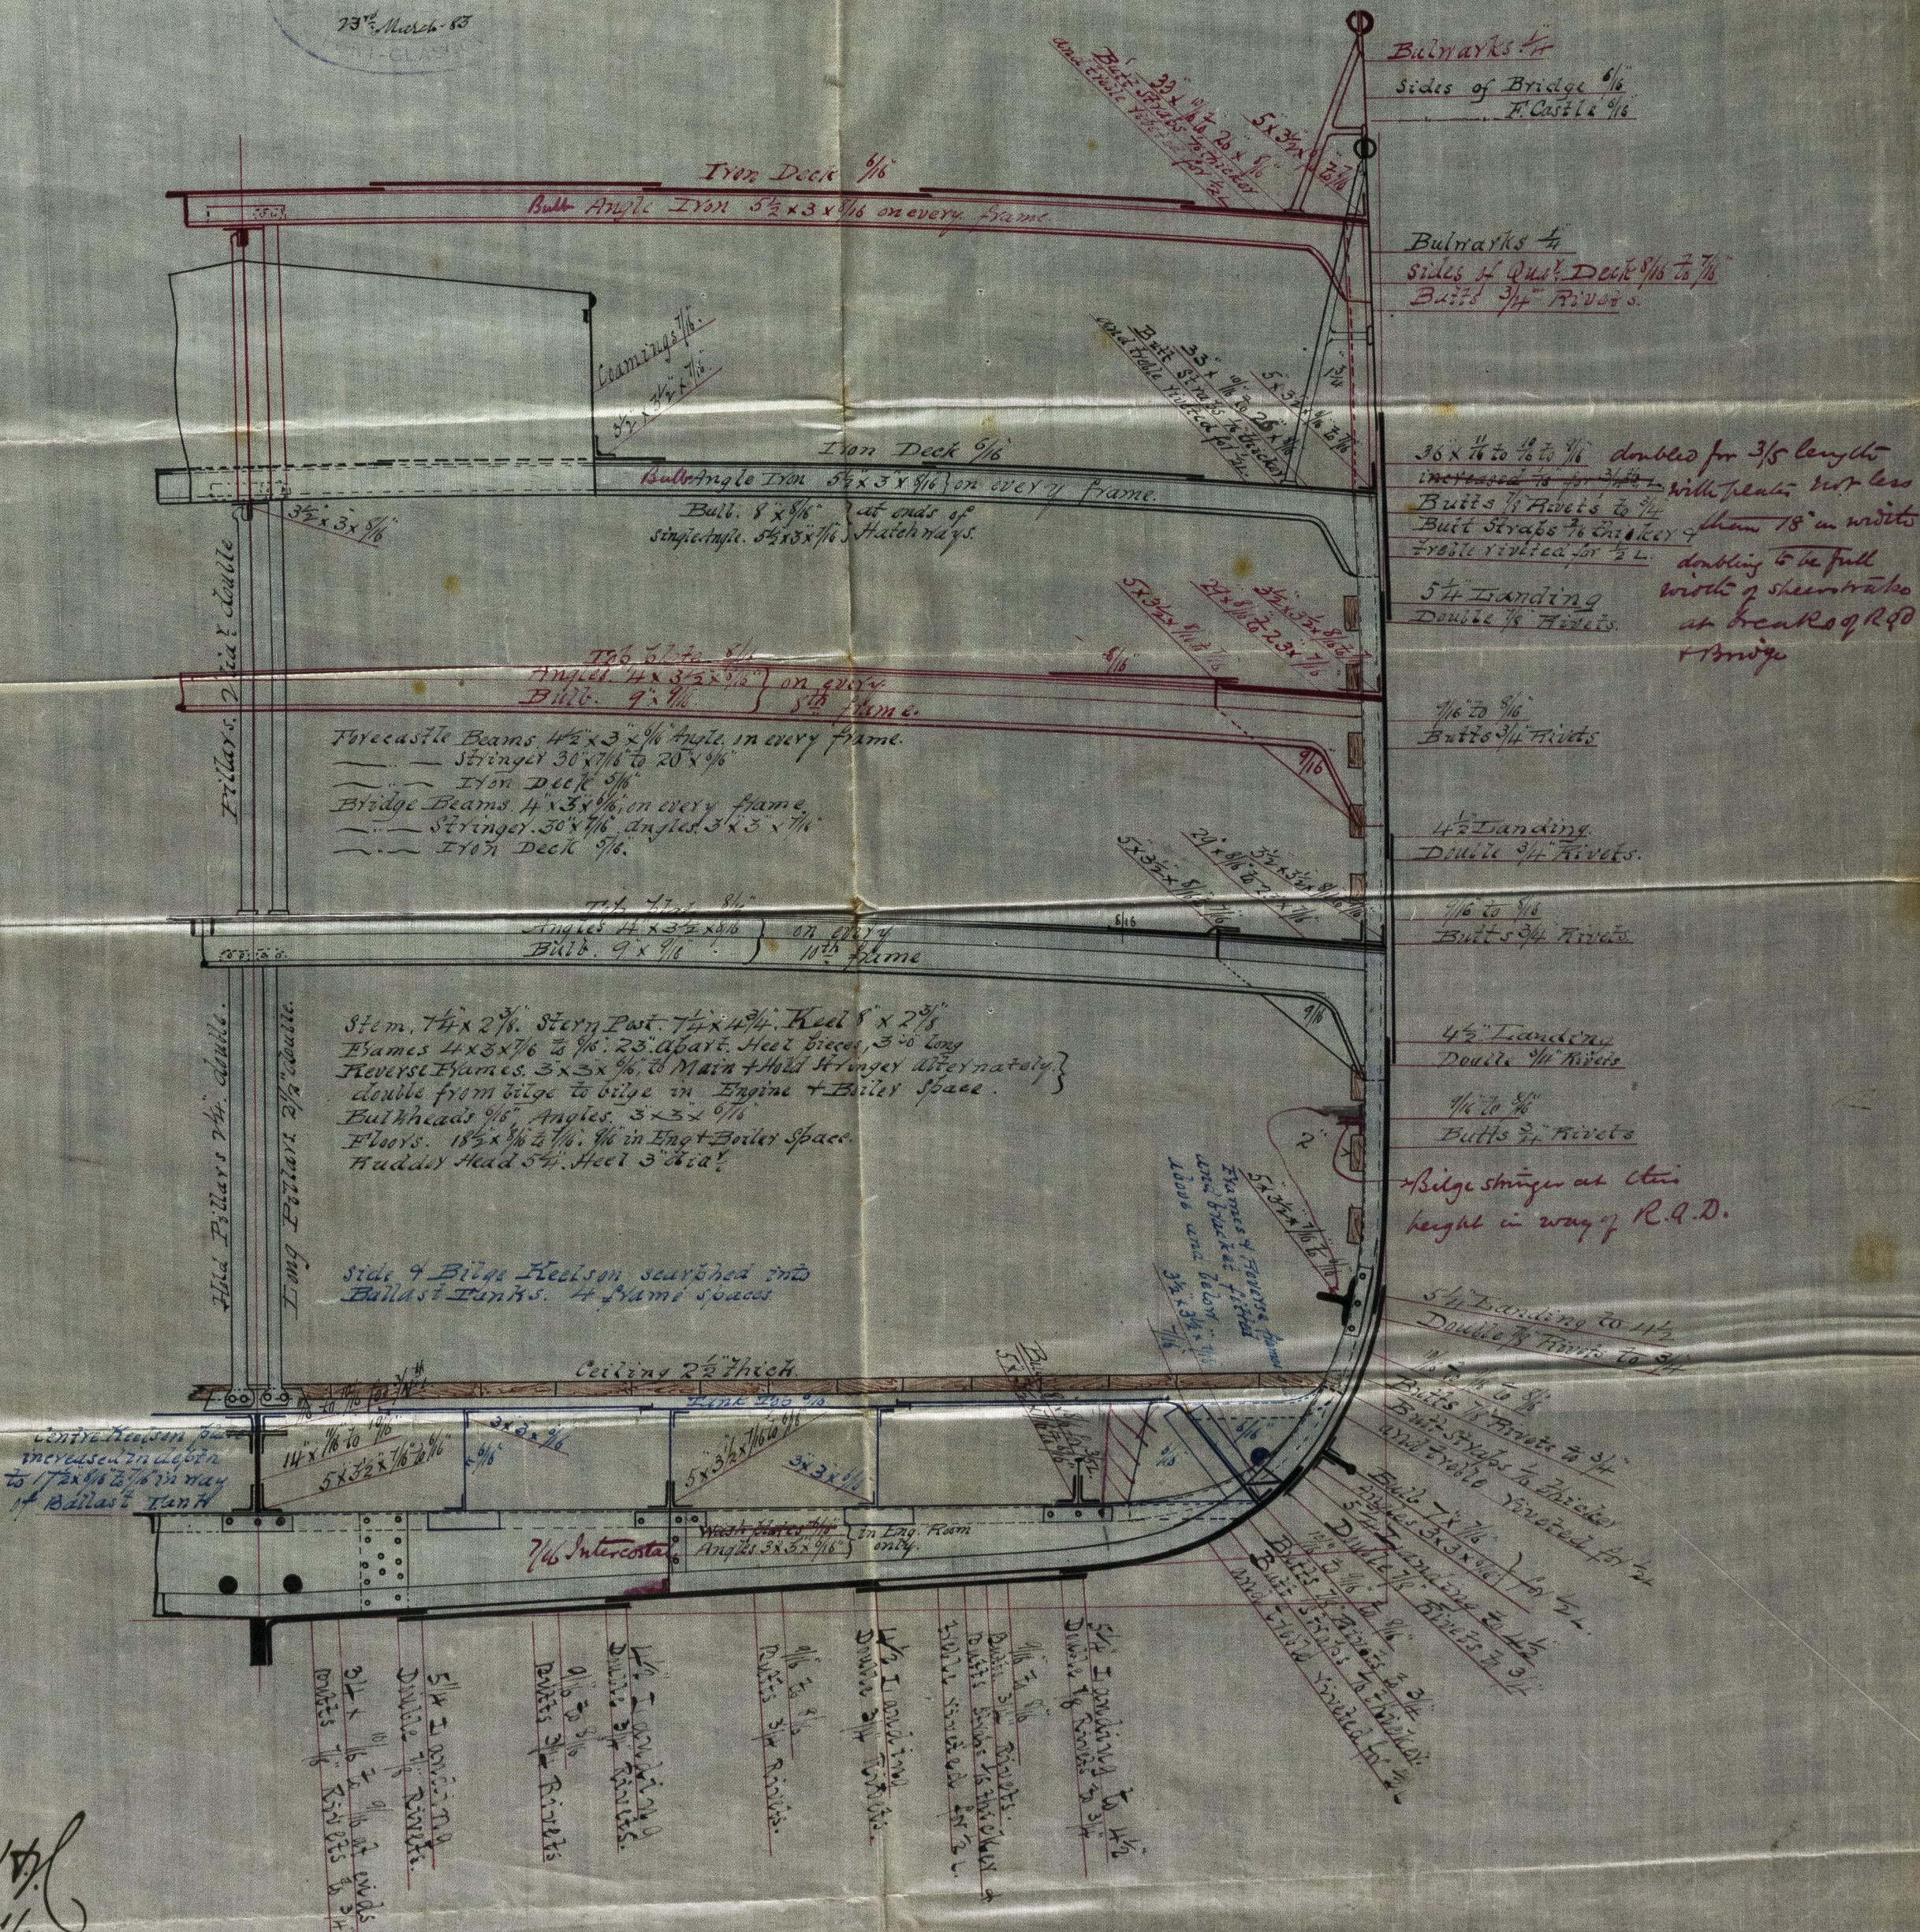

GRK 302-0193

J. V. L.
31/3/83