


2/5/83  
2/4/83

# MARINE BOILER FOR ENGINES. N<sup>o</sup> 77.

SCALE 1 INCH TO ONE FOOT

(Hull No 77. Building at  
Messrs Blacklock & Murray  
Port Glasgow

S.S. "Fortescue"  
Greenock Report No. 8703

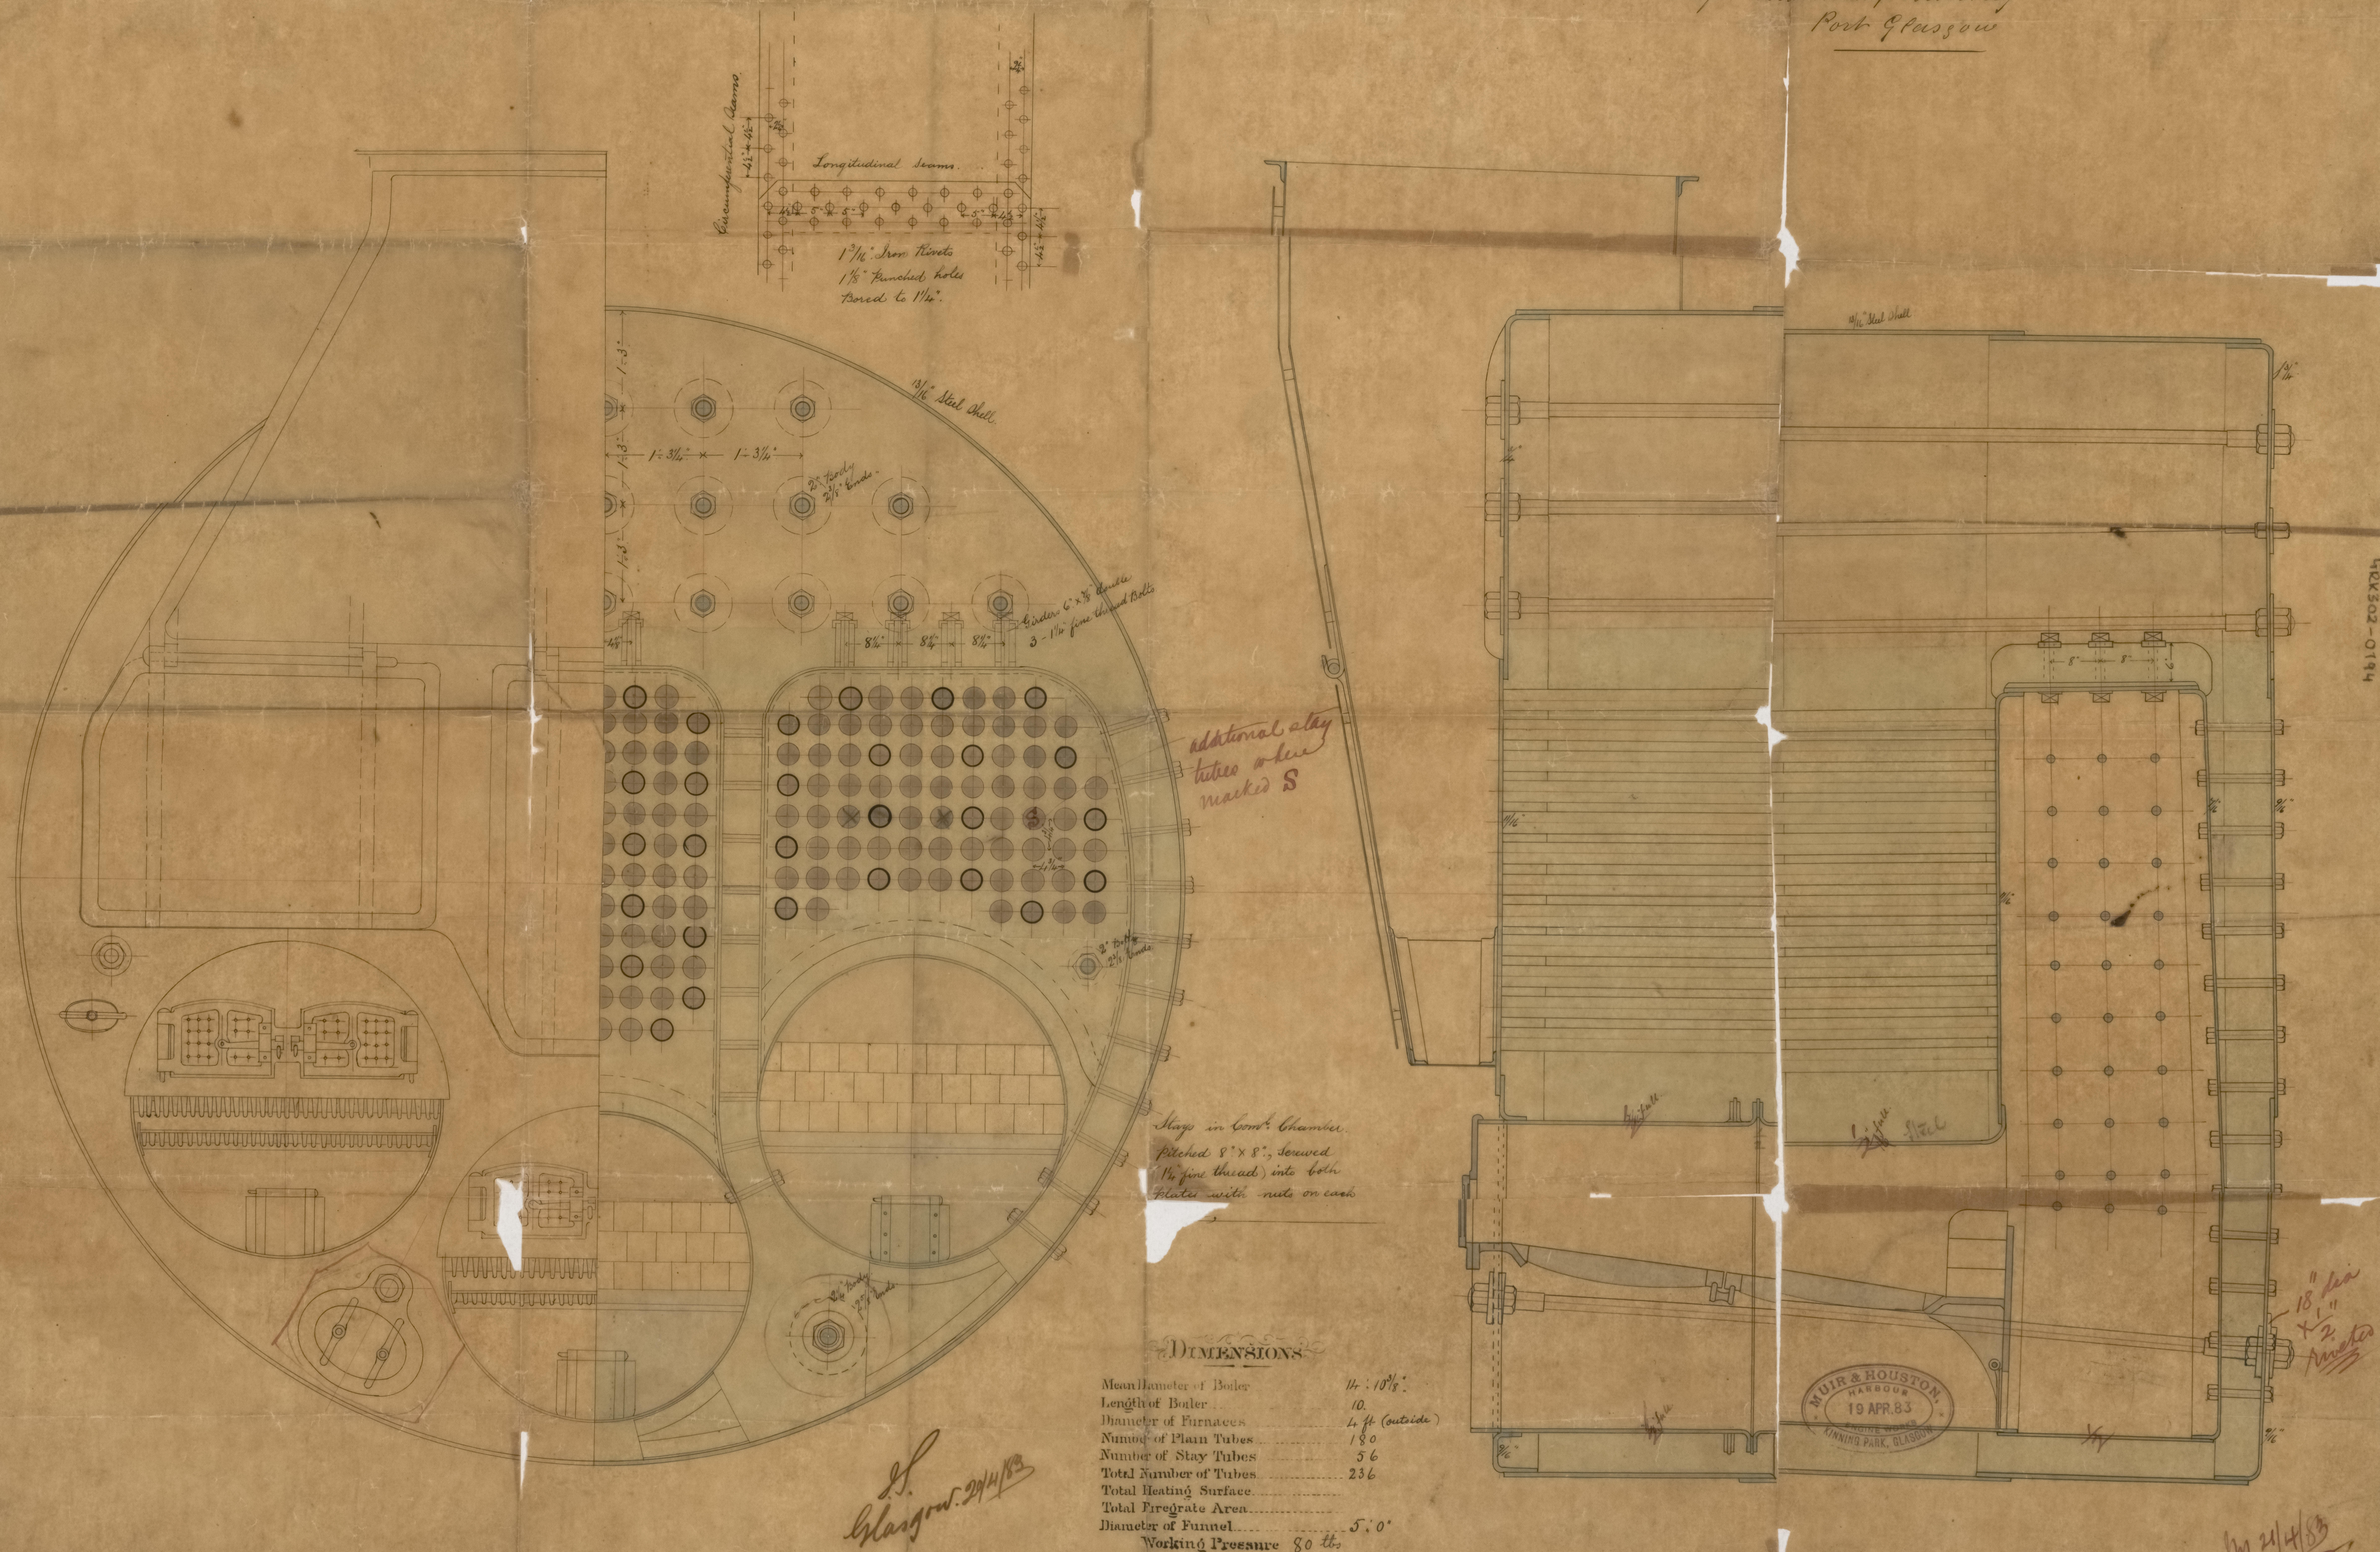

## DIMENSIONS

Mean Diameter of Boiler	14' 10 1/8"
Length of Boiler	10'
Diameter of Furnaces	4 ft (outside)
Number of Plain Tubes	180
Number of Stay Tubes	56
Total Number of Tubes	236
Total Heating Surface	
Total Firegrate Area	
Diameter of Funnel	5' 0"
Working Pressure	80 lbs

L. Glasgow 2/4/83



GRK302-0194



15/16" Steel Shell



© 2021

Lloyd's Register  
Foundation