


RECEIVED 15/MAY 83


s. s. Fortescue
Greenock Report No. 8403

Let to Messrs John Holman & Sons
3/5/83

Cabin Plan
S.S. No 77
Scale 1/4" = 1' 0"

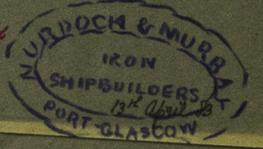

Copy
3/5/83

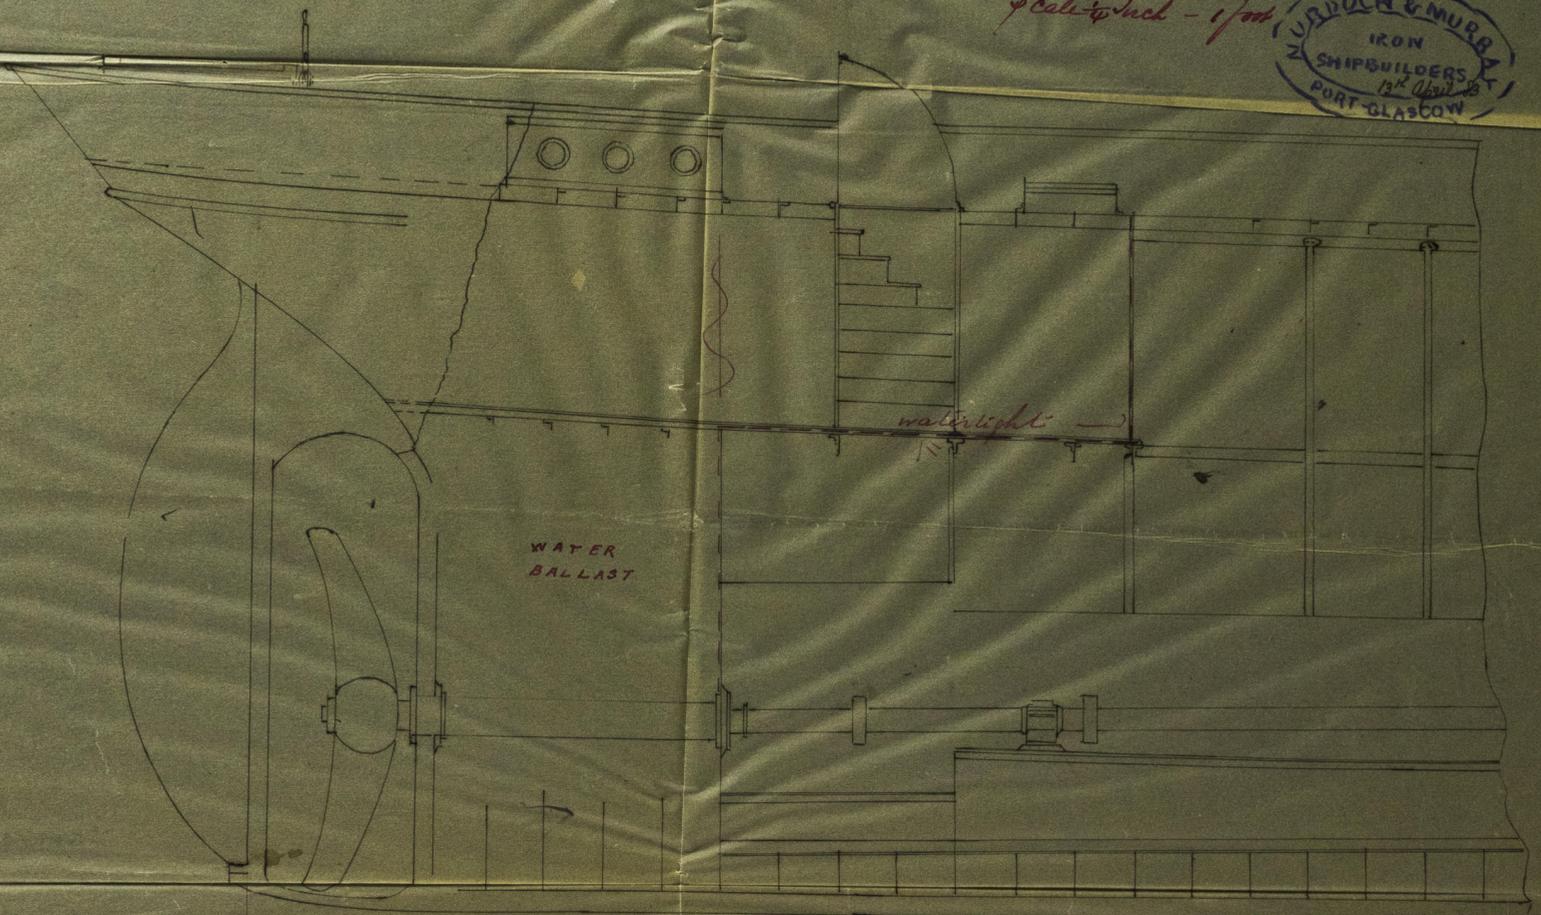

J.H.
3/5/83

