

Lloyd's Register of British and Foreign Shipping.

(Received in the London Office.)



P.

No. 352

REPORT ON SHIP FORGINGS.

Sir,

I beg leave to report that the undermentioned Forgings, manufactured by The Lancefield Forge Co of Glasgow for the Vessel No. 77, being built by Messrs Murdock & Murray of Port Glasgow have been inspected by me in course of being forged and smithed, and found to be, so far as can be seen, sound and efficient

GM 5/10/83

Mark on Forging.

Lloyd's
No. 352
G. N

I am, Sir,


Your Obedient Servant,

George Newcomb
Glasgow

The Secretary,
London.

	STERN FRAMES.	RUDDER FRAMES.	STEMS.
Material*	Scrap iron	/	/
How made	Forged		
Dimensions	4 1/2 x 4 3/4		
Progress on Inspection	Forged and smithed		
Dates when Inspected	28/8/83. 5.17.22.27/9/83. 1/10/83.		

SKETCHES OF FRAMES SHEWING POSITION AND DESCRIPTION OF WELDS.

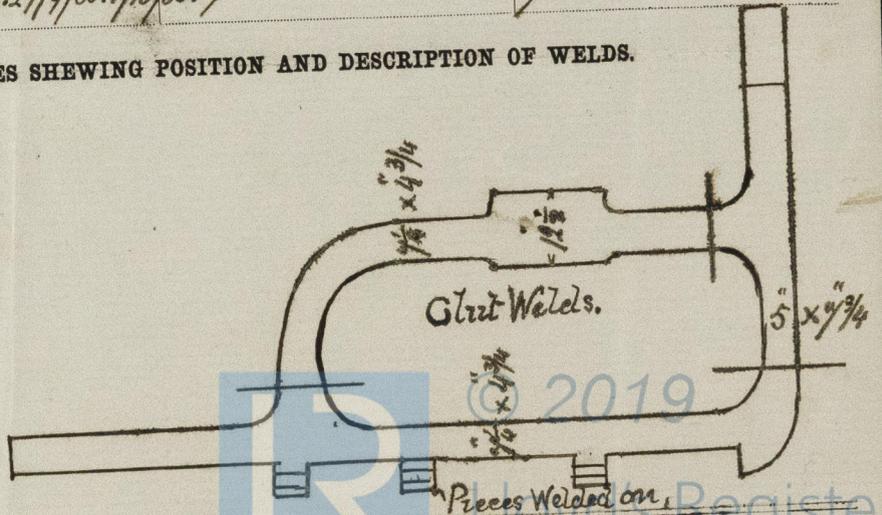

* If of iron, state whether scrap or puddled iron.