


171.83
LONDON

Dr. & Grk:
17.11.83.

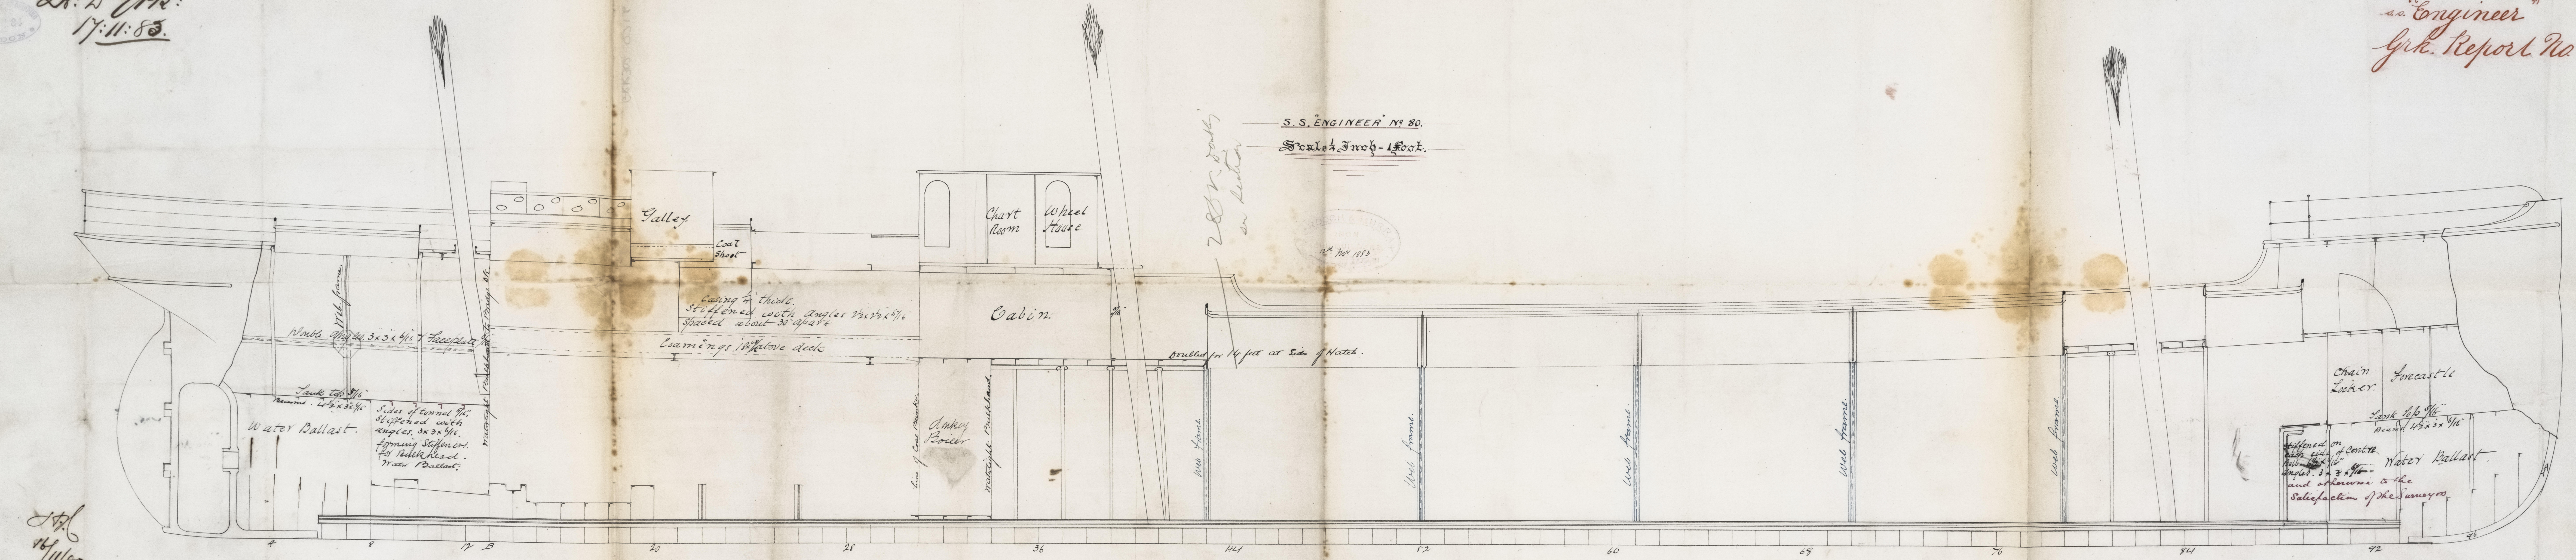

as "Engineer"
Grk. Report No.

LOD REGISTER OF SHIPS
OFFICE
GREENOCK

100021-1707

31822 R. M. 80


back
door






© 2021

Lloyd's Register
Foundation

GRK302-0216