

Lloyd's Register of British and Foreign Shipping.

(Received in the London Office,

F.

No. 594

REPORT ON SHIP FORGINGS.

Sir,

I beg leave to report that the undermentioned Forgings, manufactured by
The Portland Forge Co of *Kilmarnock*
 for the Vessel No. 80, being built by *Messrs Murdoch & Murray*
 of *Port Glasgow* have been inspected by me in course
 of being forged and smithed, and found to be, so far as can be seen, *sound and*
satisfactory

Work on Forging.

Lloyd's

No. 594

G. N.

The Secretary,
 London.

I am, Sir,

Your Obedient Servant,


George Newcomb

Glasgow

21/12/83.

	STERN FRAME.	RUDDER FRAME.	STEM.
* - - - -	Scrap iron	/	Scrap iron
made - - - -	Forged		Forged
ions - - - -	$6\frac{1}{2} \times 3\frac{3}{4}$		$6\frac{1}{2} \times 1\frac{7}{8}$
s on Inspection -	Forged and smithed		Smithing & completed
when Inspected	$31/10/83. 5.14.23. 29/11/83.$		$29/11/83. 18/12/83.$
	$8/12/83.$		

SKETCHES OF FRAMES SHEWING POSITION AND DESCRIPTION OF WELDS.

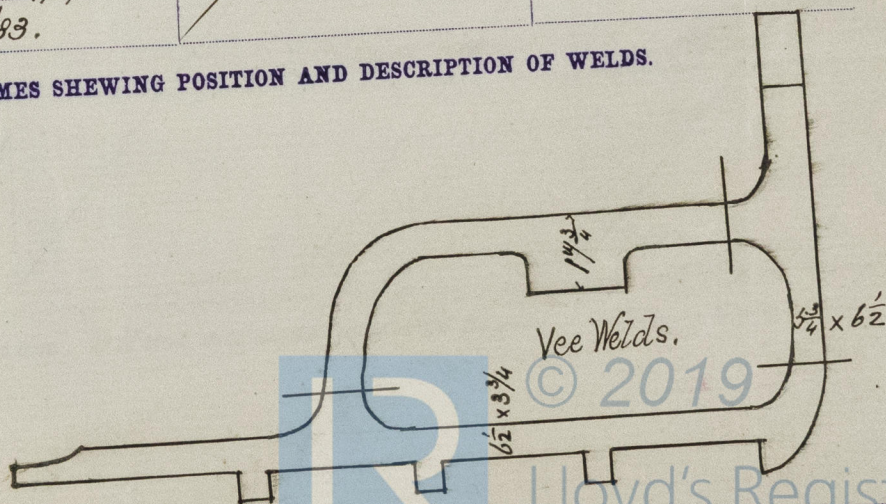

* If of iron, state whether scrap or puddled iron.