

...er's name.
Diameter of Lower Masts and Bowsprit

The masts repairs have been constructed in
a substantial manner

Lloyd's Register of British and Foreign Shipping.

(Received in the London Office,

3 NOV 83
LONDON

F.

No. 606

REPORT ON SHIP FORGINGS.

Sir,

I beg leave to report that the undermentioned Forgings, manufactured by
The Lancefield Forge Co of *Glasgow*
for the Vessel No. *Y.N*, being built by *Messrs J. Reid & Co*
of *Port Glasgow* have been inspected by me in course
of being ~~forged and~~ smithed, and found to be, so far as can be seen, ~~sound and~~
satisfactory

G.N. 31/10/83

Mark on Forging.

Lloyd's
No. 606
G.N

I am, Sir,

Your Obedient Servant,


George Newcomb

The Secretary,
London.

Glasgow

	<i>Post</i> STERN FRAME	RUDDER FRAME	STEM
Material*	<i>Scrap iron</i>		
How made	<i>Forged</i>		
Dimensions	<i>11 x 2 3/4</i>		
Progress on Inspection	<i>Smithing & completed</i>		
Dates when Inspected	<i>30.31/10/83.</i>		

SKETCHES OF FRAMES SHEWING POSITION AND DESCRIPTION OF WELDS.

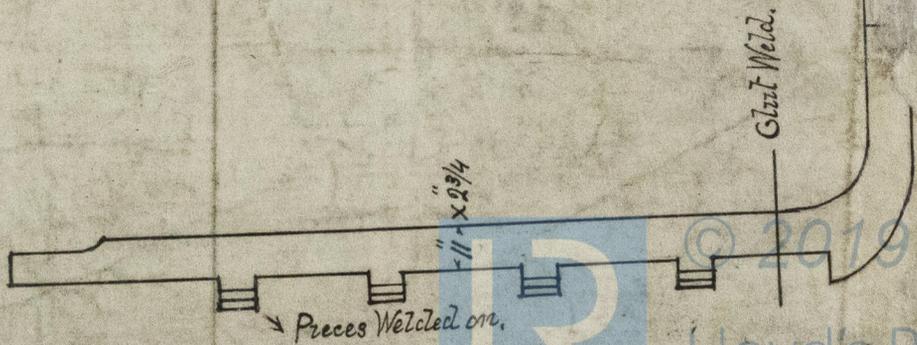

* If of iron, state whether scrap or puddled iron.

Lloyd's Register
Foundation

GRN 303-0013