




RECEIVED
21 NOV. 83
LONDON

RECEIVED
1 DEC. 83
LONDON

See to Spec.
26.11.83
11.12.83
19/1/84

ship "British Isles"
G.R. Report No. 8730

J. M. Masts
Rams double riveted
Butts double riveted
Steel angles 4 x 3 x 1/2 in. 6 in. x 2 in. 3/4 in. 1/2 in. 3/8 in.
3/4 in. 1/2 in. 3/8 in.

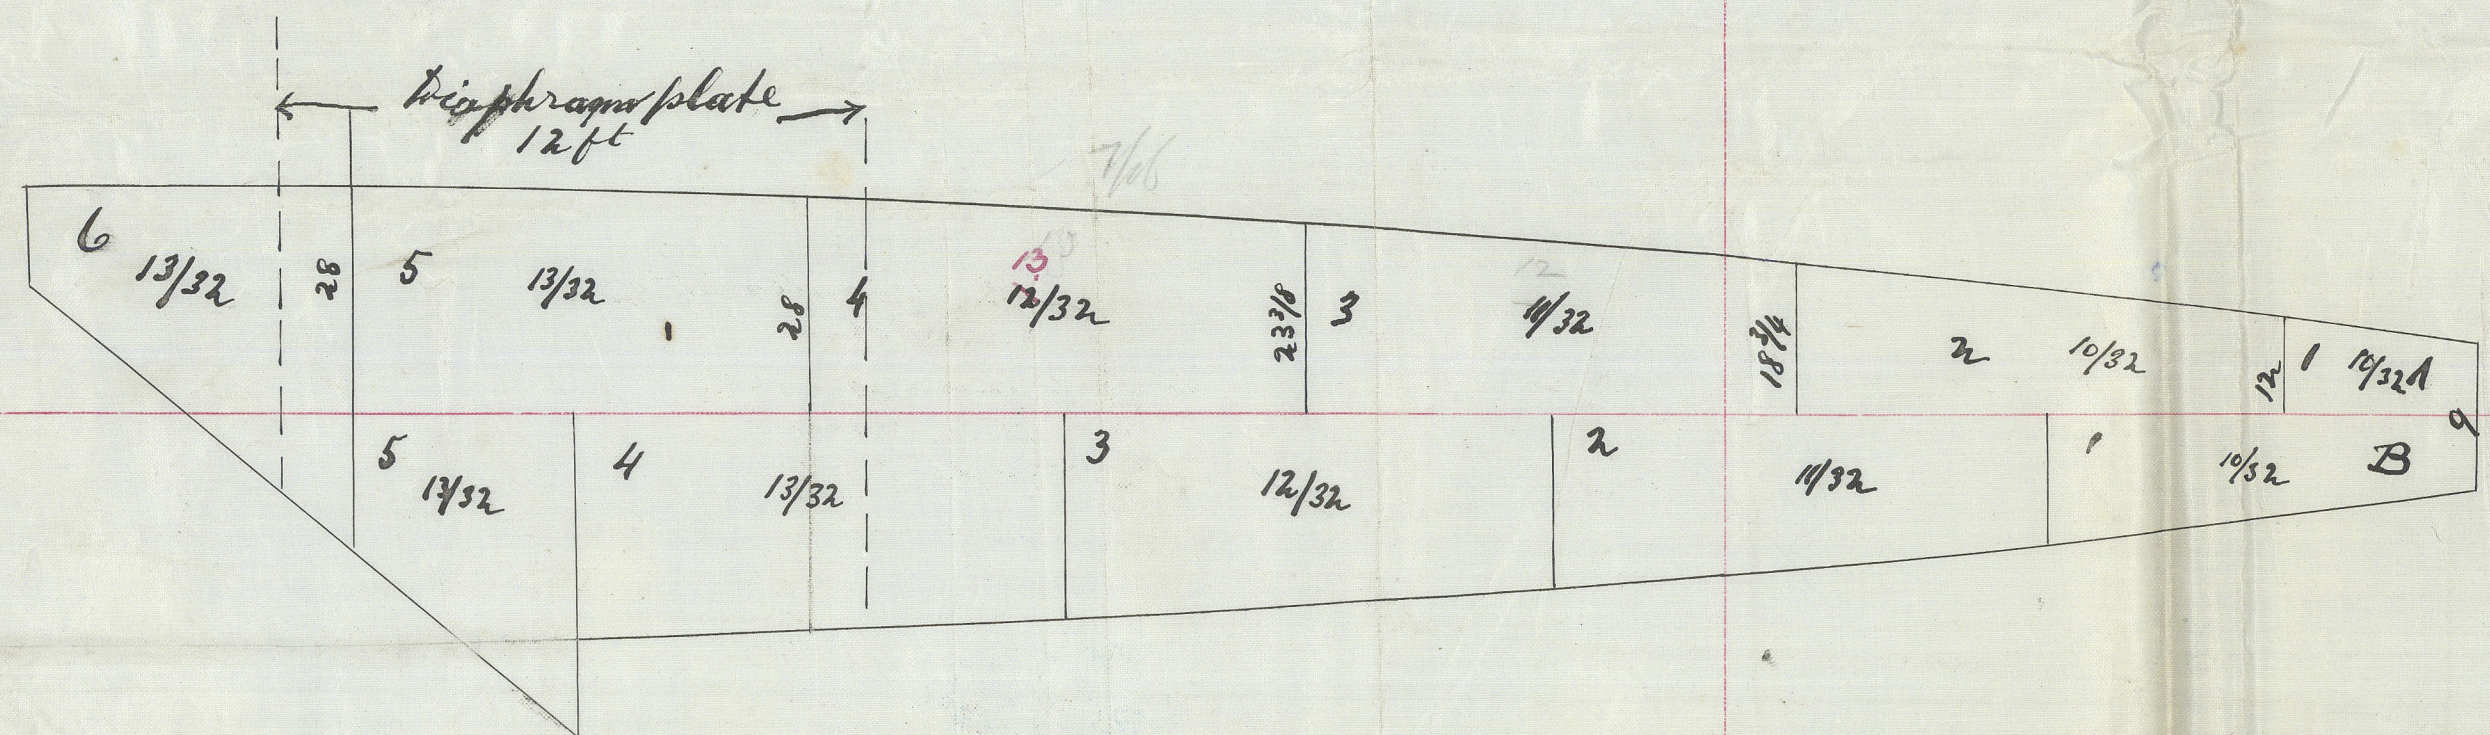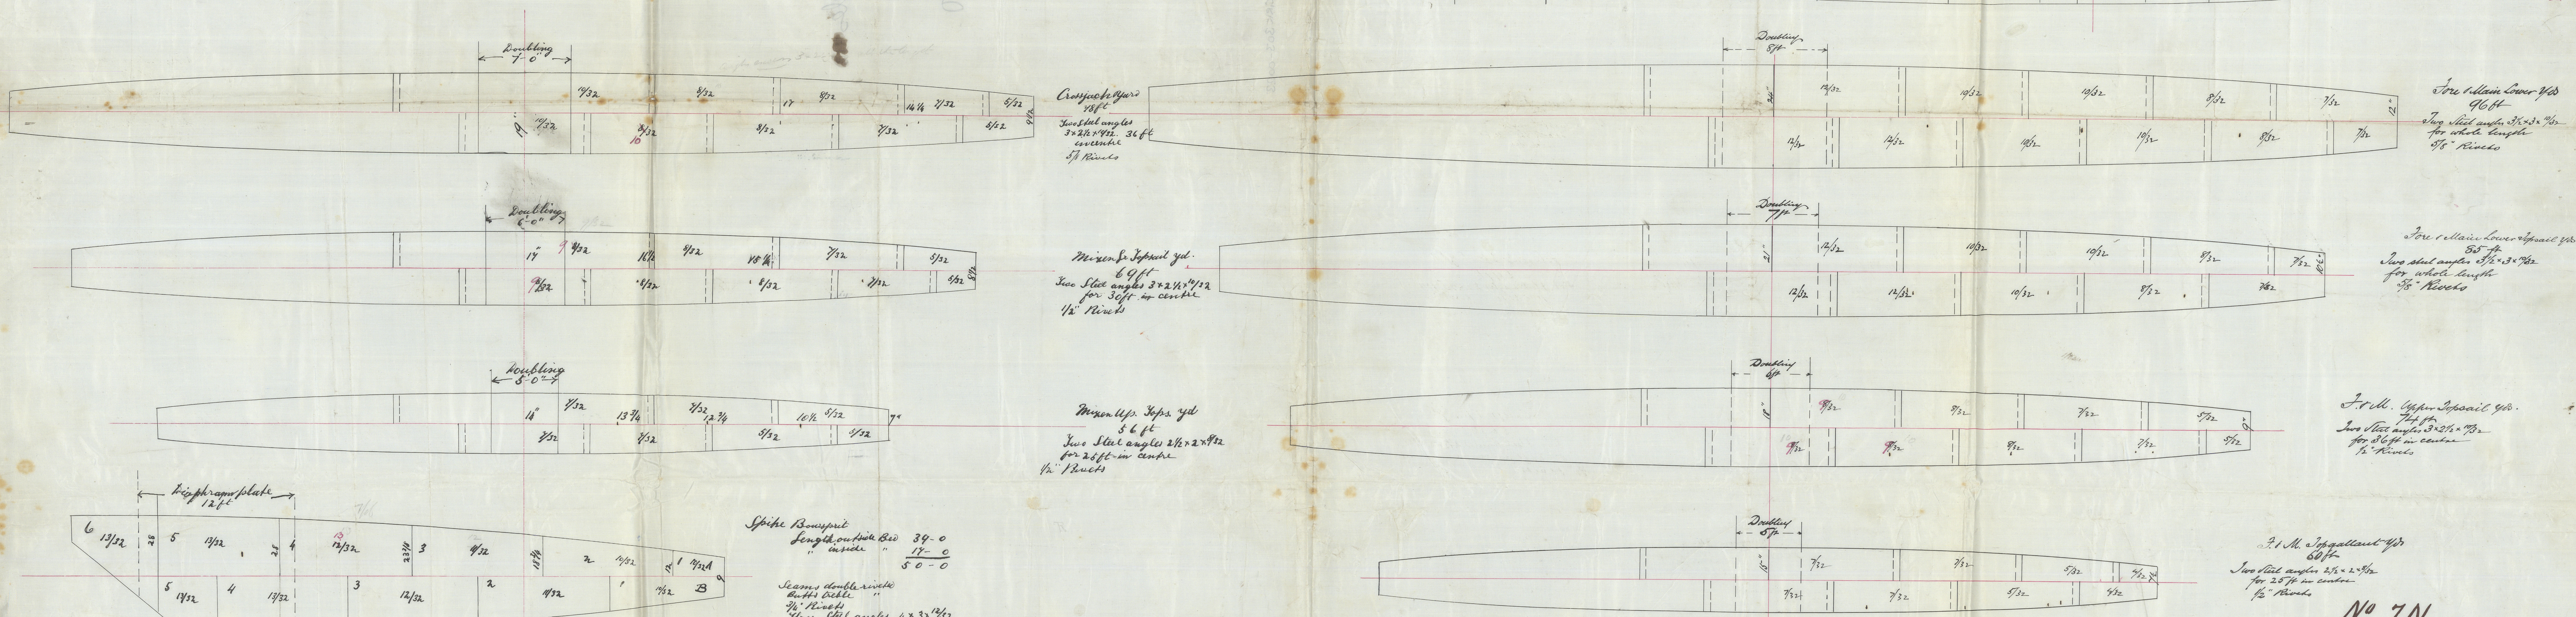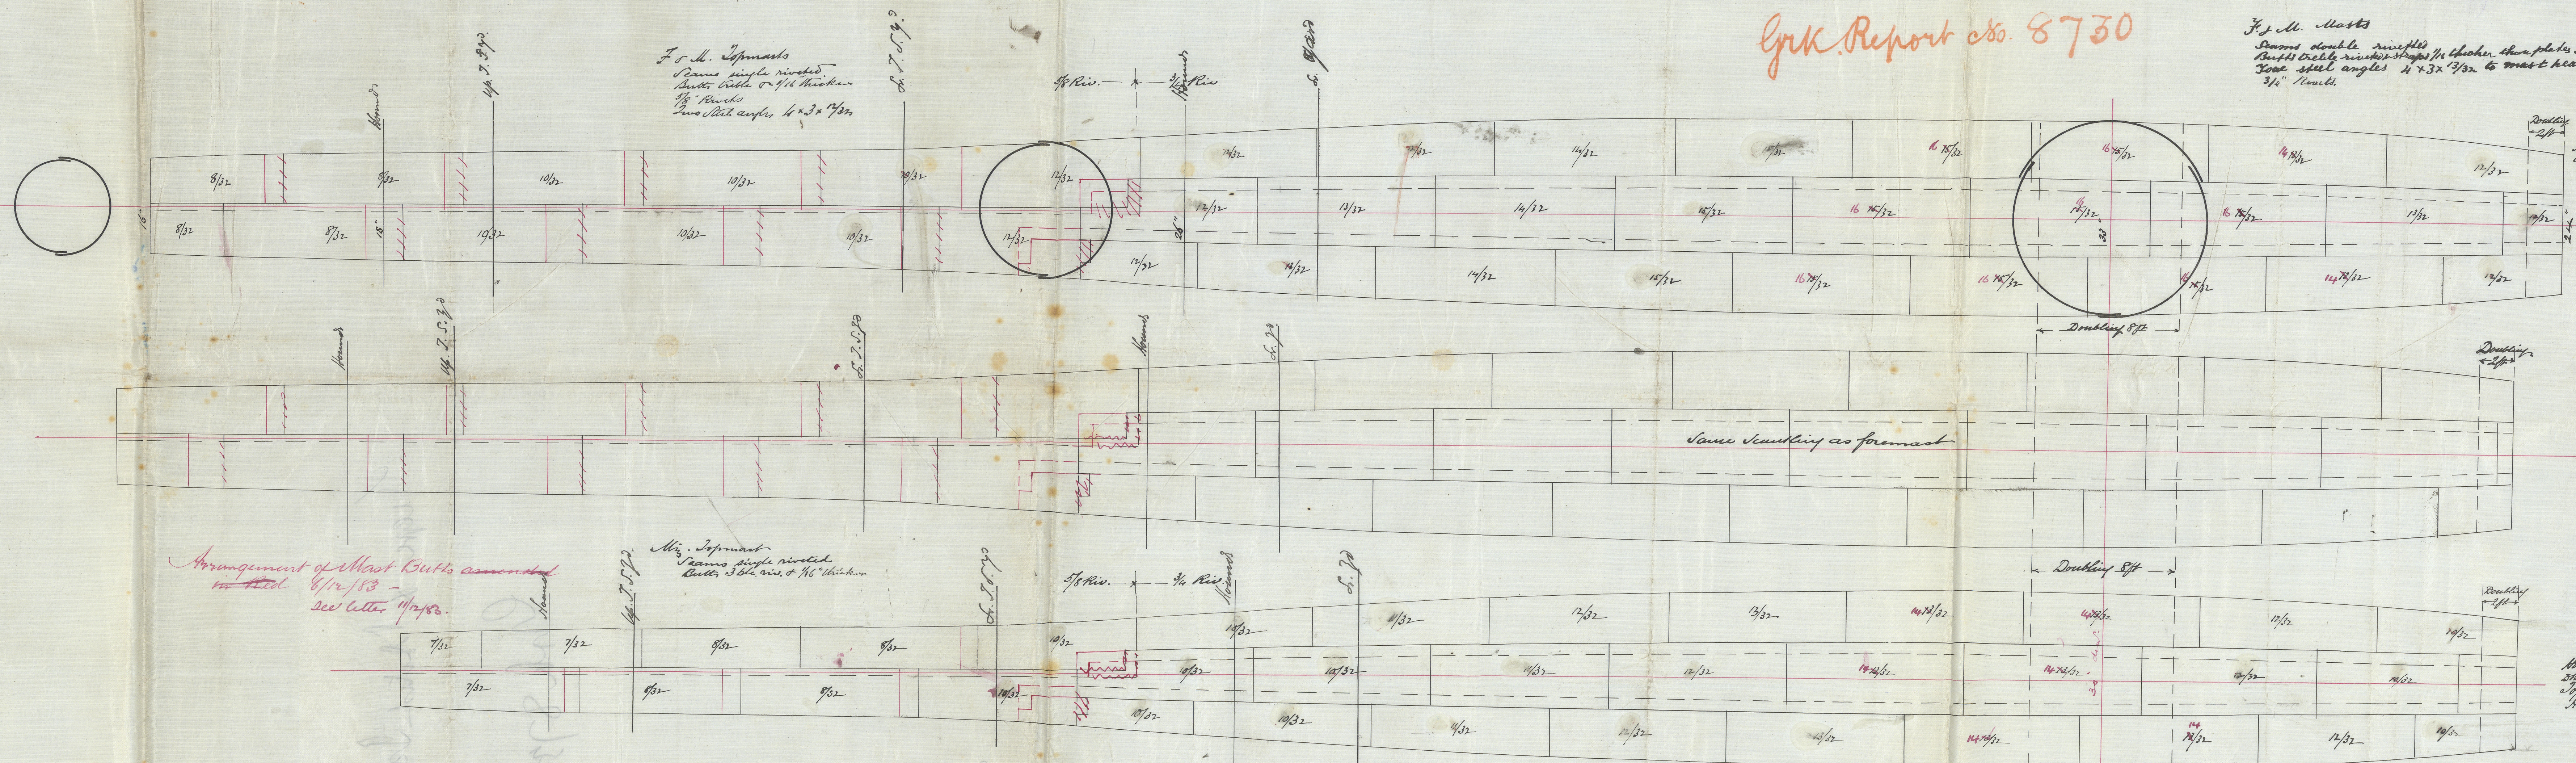

Spoke Bonaparte
Length outside 34.0
" inside 17.0
50.0
Seams double riveted
Butts double riveted
Steel angles 4 x 3 x 1/2 in.

See letter to Greenwich
as to mast.
24/1/84

No. 7N
Steel Mast & Yards

Trepe x Artist Isles

Grk 8730



© 2020
GRK 303-0023

Lloyd's Register
Foundation