

Ship General Roberts Greenock Report No. 8750

Half Midship Section

Ship N° 106

To be classed 100 A.1.
Scale 1/2 inch = 1 foot

Dr. L. G. K.


15/9/83

44464

Under 10 & under 7 Breadth to length

Reg. Dem 274.0 x 40.2 x 24.3

1/2 Breadth	41.75	
1/2 Breadth	19.465	19 11/2 moulded
Depth	26.92	
	88.635	1st N°
	260.5	Length
	23084.42	2nd N°
	1534.3	115th added for Poop
	24628.72	Equipment

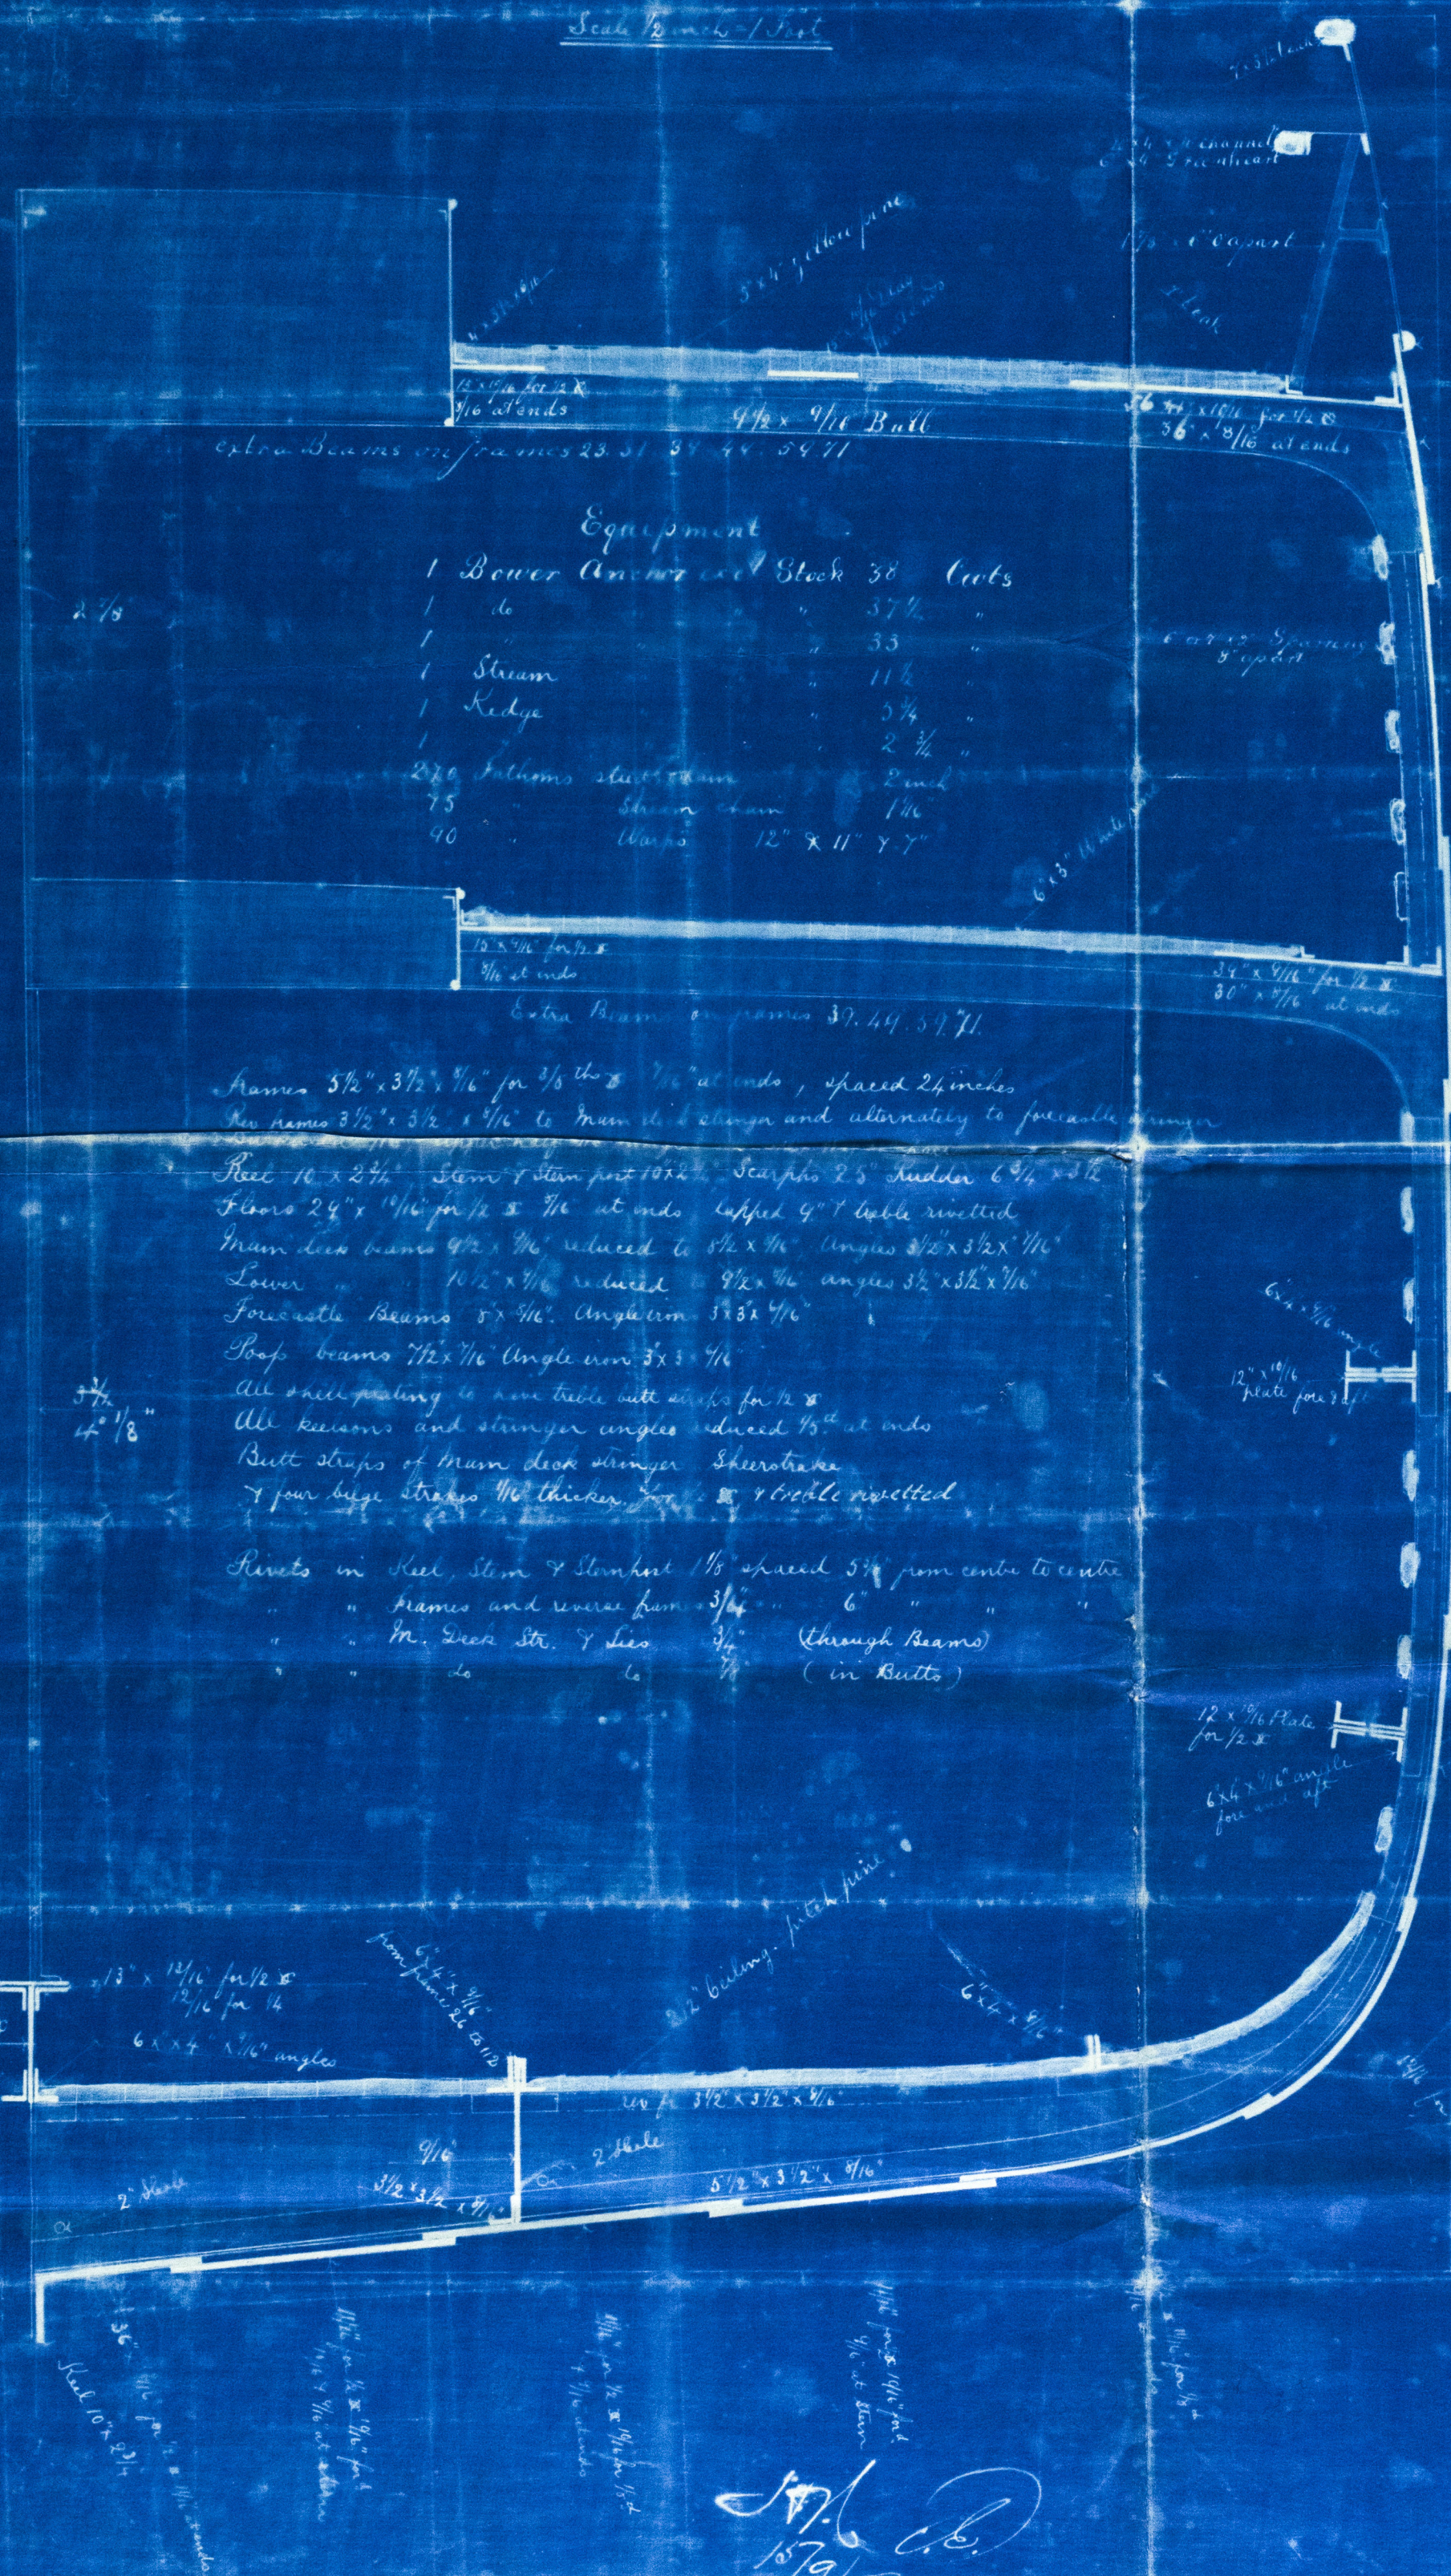

Equipment

1 Bower Anchor and Stock	38	Cwt
1 do	37 1/2	"
1 do	33	"
1 Stream	11 1/2	"
1 Kedge	5 3/4	"
1 do	2 1/2	"
220 Fathoms steel chain	2	inch
75 " "	1 1/2	"
40 " "	12" x 11" x 7"	"

Frames 5 1/2" x 3 1/2" x 1/16" for 3/8" to 1/2" at ends, spaced 24 inches
 Keel frames 3 1/2" x 3 1/2" x 1/16" to main deck stringer and alternately to fore-castle stringer
 Plating 16 x 2 1/4" Stem & Stern post 10 x 2 1/2" Scarphs 25" Sudders 6 3/4" x 3 1/2"
 Floors 24" x 1 1/16" for 1/2" & 1/16" at ends, lapped 9" & bolted rivetted
 Main deck beams 9 1/2" x 1 1/16" reduced to 8 1/2" x 1 1/16" Angles 3 1/2" x 3 1/2" x 1/16"
 Lower " 10 1/2" x 1 1/16" reduced to 9 1/2" x 1 1/16" angles 3 1/2" x 3 1/2" x 1/16"
 Fore-castle Beams 8 x 1 1/16" Angle iron 3 x 3 x 1/16"
 Poop beams 7 1/2 x 1 1/16" Angle iron 3 x 3 x 1/16"
 All shell plating to main table with strips for 1/2" &
 All keelsons and stringer angles reduced 1/8" at ends
 Butt strips of main deck stringer Sheerstrakes
 & four large strakes 1 1/2" thicker for 1/2" & 1/16" rivetted
 Rivets in Keel, Stem & Stern post 1/8" spaced 5 1/4" from centre to centre
 " " Frames and keelsons from 3/16" " 6" " "
 " " M. Deck Str. & Sheer 3/16" (through Beams)
 " " do do 1/4" (in Butts)

J.M. C.D.
15/9/83

