

Lloyd's Register of British and Foreign Shipping

(Received in the London Office,

22 OCT. 83

F.

No. 367

REPORT ON SHIP FORGINGS.

Sir,

I beg leave to report that the undermentioned Forgings, manufactured by The Portland Forge Co of Kilmarnock for the Vessel No. 3, being built by Messrs McKnight, McCreddie & Co of Ayr have been inspected by me in course of being forged and smithed, and found to be, so far as can be seen, sound and satisfactory

D.S.
23/10/83

Mark on Forging.

Lloyd's

No. 367

C. N

The Secretary,
London.

I am, Sir,


Your Obedient Servant,

George Newcomb

Glasgow

	STERN FRAME.	RUDDER FRAME.	STEM.
Material* - - - -	Scrap iron		
How made - - - -	Forged		
Dimensions - - - -	6 1/4 x 3 1/4		
Progress on Inspection -	Forged and smithed		
Dates when Inspected	9.16/8/83. 14.24.27/9/83. 4.17/10/83.		

SKETCHES OF FRAMES SHEWING POSITION AND DESCRIPTION OF WELDS.

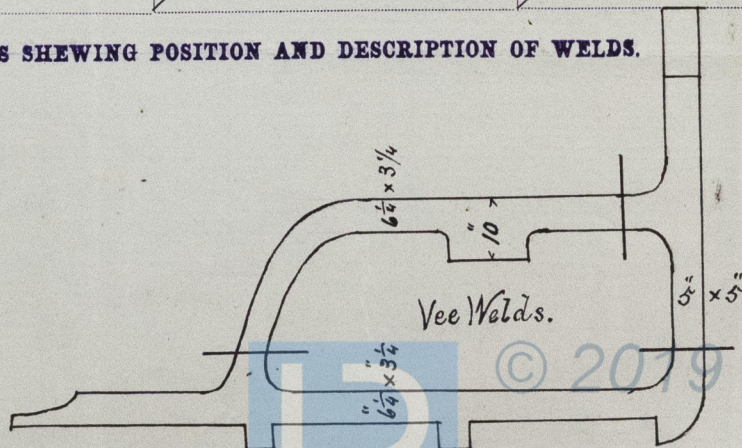

* If of iron, state whether scrap or puddled iron.