


23/4/84

S.S. N<sup>o</sup> 3  
Pumping Arrangement  
Scale 1/4" = 1 Foot

S.S. Coila  
Greenock Report No 8734

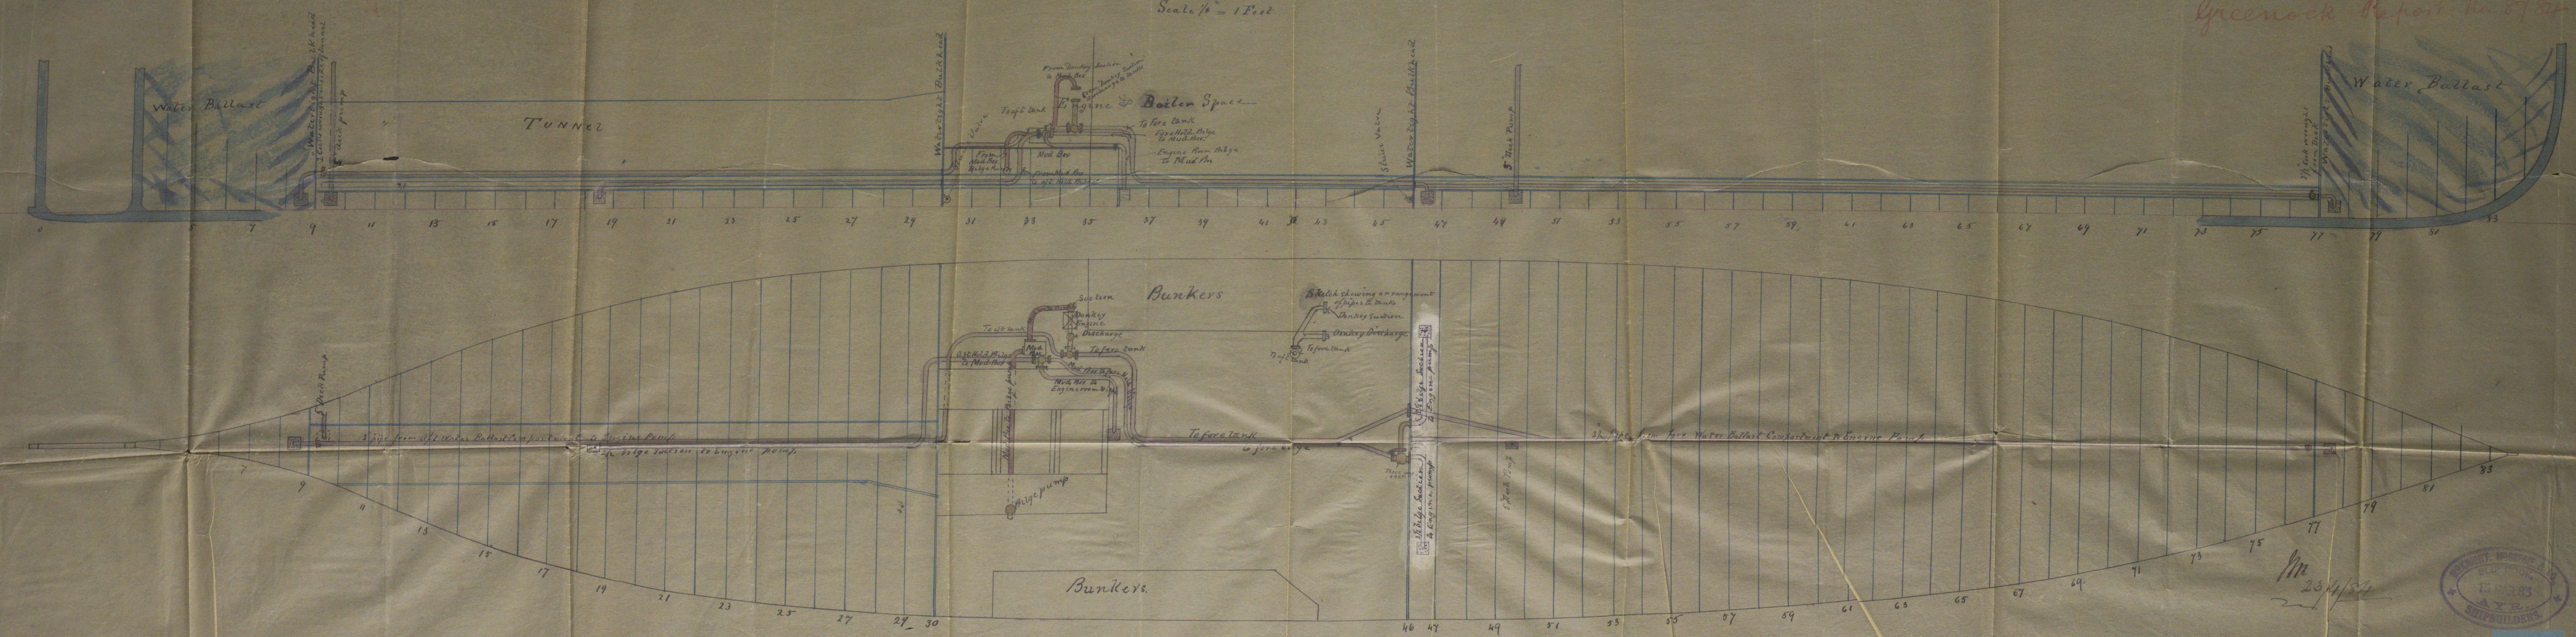

23/4/84

