

Lloyd's Register of British and Foreign Shipping.

(Report on Vessel No. _____ Port _____)

No. 796 **SHIP FORGINGS OR CASTINGS.**

I have to report that the undermentioned Iron ~~or Steel~~ Forgings ~~or Castings~~, manufactured by The Vulcan Forge Co of Dalmuir, for the Vessel No. 109, being built by Messrs Russell & Co of Port Glasgow have been inspected by me as set forth below, and found to be, so far as can be seen, sound and efficient.

Mark on Forgings.

Lloyd's
No. 796
G.N.


George Newcomb

Glasgow.

26/4/84.

	STERN FRAME.	RUDDER FRAME.	STEM & Keel bars
Material*	<u>Scrap iron</u>	<u>Scrap iron</u>	<u>Scrap iron</u>
How made	<u>Forged</u>	<u>Forged</u>	<u>Forged</u>
Dimensions	<u>8 1/2 x 2 1/2</u>	<u>6 1/2 and 3/4</u>	<u>8 1/2 x 2 1/2</u>
Progress on Inspection	<u>Forged and smithed</u>	<u>Forged and smithed</u>	<u>Forging & completed</u>
Dates when Inspected	<u>24.28/3/84. 3.10/4/84.</u>	<u>28/3/84. 3.10.16.22/4/84.</u>	<u>17.24.28/3/84. 3.10/4/84.</u>

SKETCHES OF FRAMES SHEWING POSITION AND DESCRIPTION OF WELDS OF FORGINGS, OR PARTICULARS OF TESTS APPLIED TO CASTINGS.

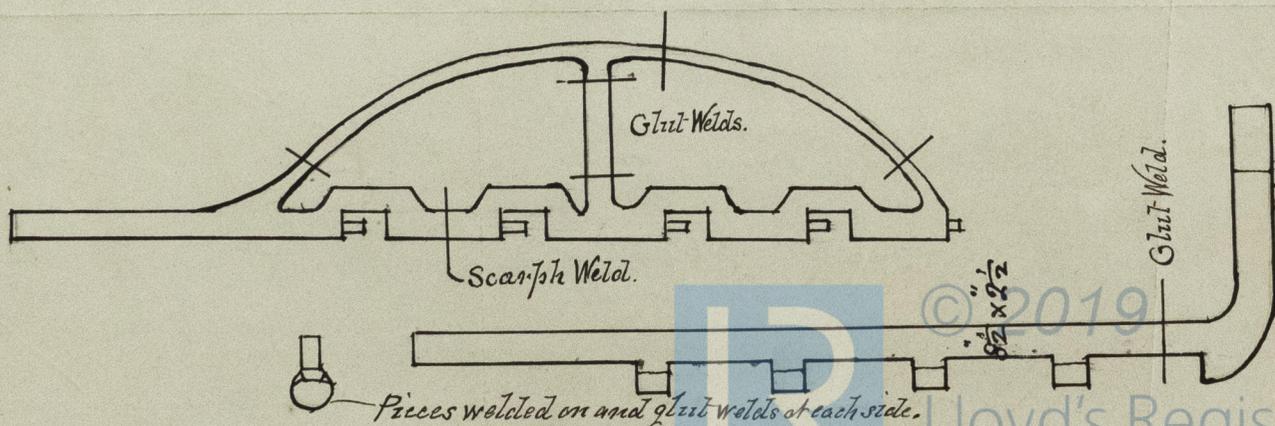

* If of Iron, state whether scrap or puddled iron.