

# Lloyd's Register of British and Foreign Shipping.

(Report on Vessel No. \_\_\_\_\_ Port \_\_\_\_\_)

No. *III.A.*

## SHIP FORGINGS OR CASTINGS.

I have to report that the undermentioned Iron or Steel Forgings or Castings, manufactured by *The Darlington Forge Co* of *Darlington* for the Vessel No. *215*, being built by *Wm. R. Duncan & Co.* of *Port Glasgow* have been inspected by me as set forth below, and found to be, so far as can be seen, *sound and efficient.*

Mark on Forgings.

Lloyd's

No. *III.A.*


*206.*

*H. Common.*

*Sunderland.*

	STERN FRAME. <i>Post</i>	RUDDER FRAME.	STEM.
Material*	<i>Scrap Iron</i>	<i>Scrap Iron</i>	<i>Scrap Iron</i>
How made	<i>Forged</i>	<i>Forged</i>	<i>Forged</i>
Dimensions	<i>9" x 2 1/2"</i>	<i>4"</i>	<i>9' x 2 1/2" b 4' x 2 1/2"</i>
Progress on Inspection	<i>Forged &amp; smithed</i>	<i>Forged &amp; smithed</i>	<i>Forged</i>
Dates when Inspected	<i>June 26 July 1. 9-16. 23/84</i>	<i>July 1-9-16. 23-30 Aug 6-13 25-29 Sept 6-15-18-25 Oct 2/84</i>	<i>July 1/84</i>

SKETCHES OF FRAMES SHEWING POSITION AND DESCRIPTION OF WELDS OF FORGINGS, OR PARTICULARS OF TESTS APPLIED TO CASTINGS.

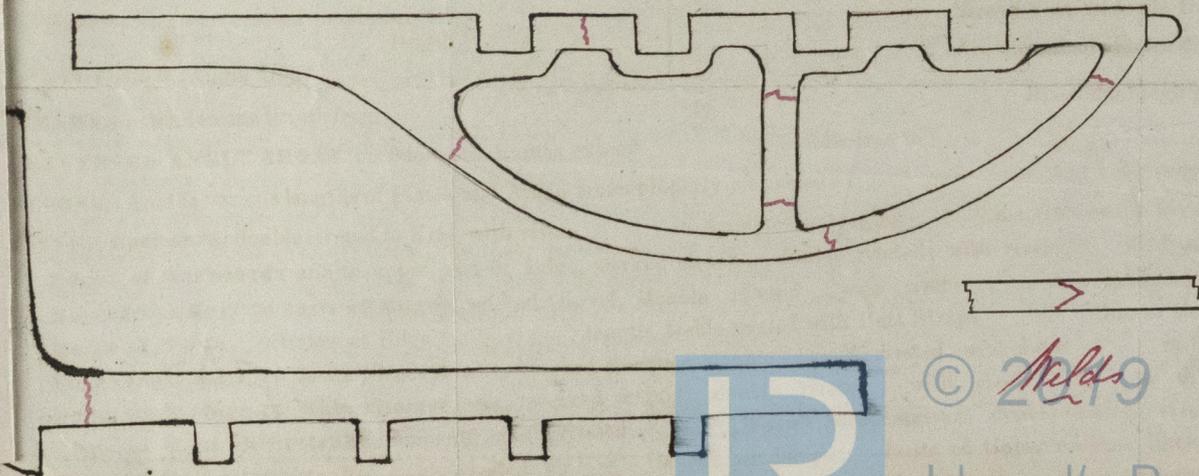

© *Melds* 2019

Lloyd's Register Foundation

GRR 304-0025

\* If of Iron, state whether scrap or puddled Iron.