

S.S. No 56 - MIDSHIP SECTION
350 x 41 x 33.10 HOLD TO SPAR DECK
CLASS-100 A. "SPAR DECKED"

Proportions
Depth = 12.13
Beams = 8.149.

Half Birt = 13.16
Beam = 20.5
Depth = 33.0
 $91.66 \times 31.816 = 2919.2$
 348.16
 349.16
 33.28
 29.664
 37.91 23756

Riveting. The butt straps of the spar & main deck sheer strakes and stringer plates, and of three strakes of plating at the sides to be $\frac{1}{16}$ thicker than the plates they connect & be rivetted $\frac{1}{2}$ L.

Equipment

Half Birt	54.16
Beam	20.5
Depth	33.0
	107.66
	348.16
	64.896
	107.66
	861.28
	43064
	32298
	37482


Anchors

2 Bowers	40 cwt ex stock	Total 114 cwt
1 Bower	34 "	
1 Stream	12 "	
1 Keel	6 "	
1 "	3 "	

Cables & Harps.

300 Fathoms	$\frac{3}{16}$ Stud chain Cable
90 "	$\frac{1}{16}$ Steam "
120 "	13" Portline
90 "	10" Hawser
90 "	9" Harp.

SCALE $\frac{1}{2}$ INCH = 1 FOOT.

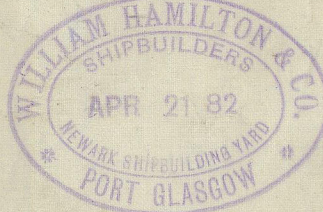

Nº 56