

Lloyd's Register of British and Foreign Shipping.

(Received in the London Office)

23 AUG 83  
LONDON

P.

No. ✓

REPORT ON SHIP FORGINGS.

Sir,

I beg leave to report that the undermentioned Forgings, manufactured by Messrs Wm Dixon, Ltd of Glasgow for the Vessel No. 56, being built by Messrs W. Hamilton & Co of Port Glasgow have been inspected by me in course of being forged and smithed, and found to be, so far as can be seen, sound and efficient

M 23/8/83

Mark on Forging.

Lloyd's  
No. ✓  
G.N

The Secretary,  
London.


I am, Sir,

Your Obedient Servant,

George Newcomb  
Glasgow

	STERN FRAMES.	RUDDER FRAMES.	STEMS.
Material*	/	Scrap iron	/
How made	/	Forged	/
Dimensions	/	9 x 4 to 6 1/2 x 6	/
Progress on Inspection	/	Forged and smithed.	/
Dates when Inspected	/	18/3/83. 18.26/6/83. 27/7/83. 3.10.16.20/8/83.	/

SKETCHES OF FRAMES SHEWING POSITION AND DESCRIPTION OF WELDS.

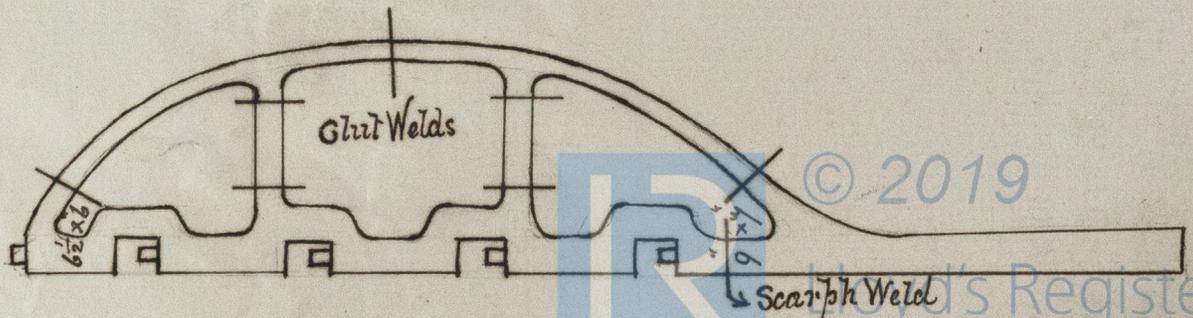

\* If of iron, state whether scrap or puddled iron.