
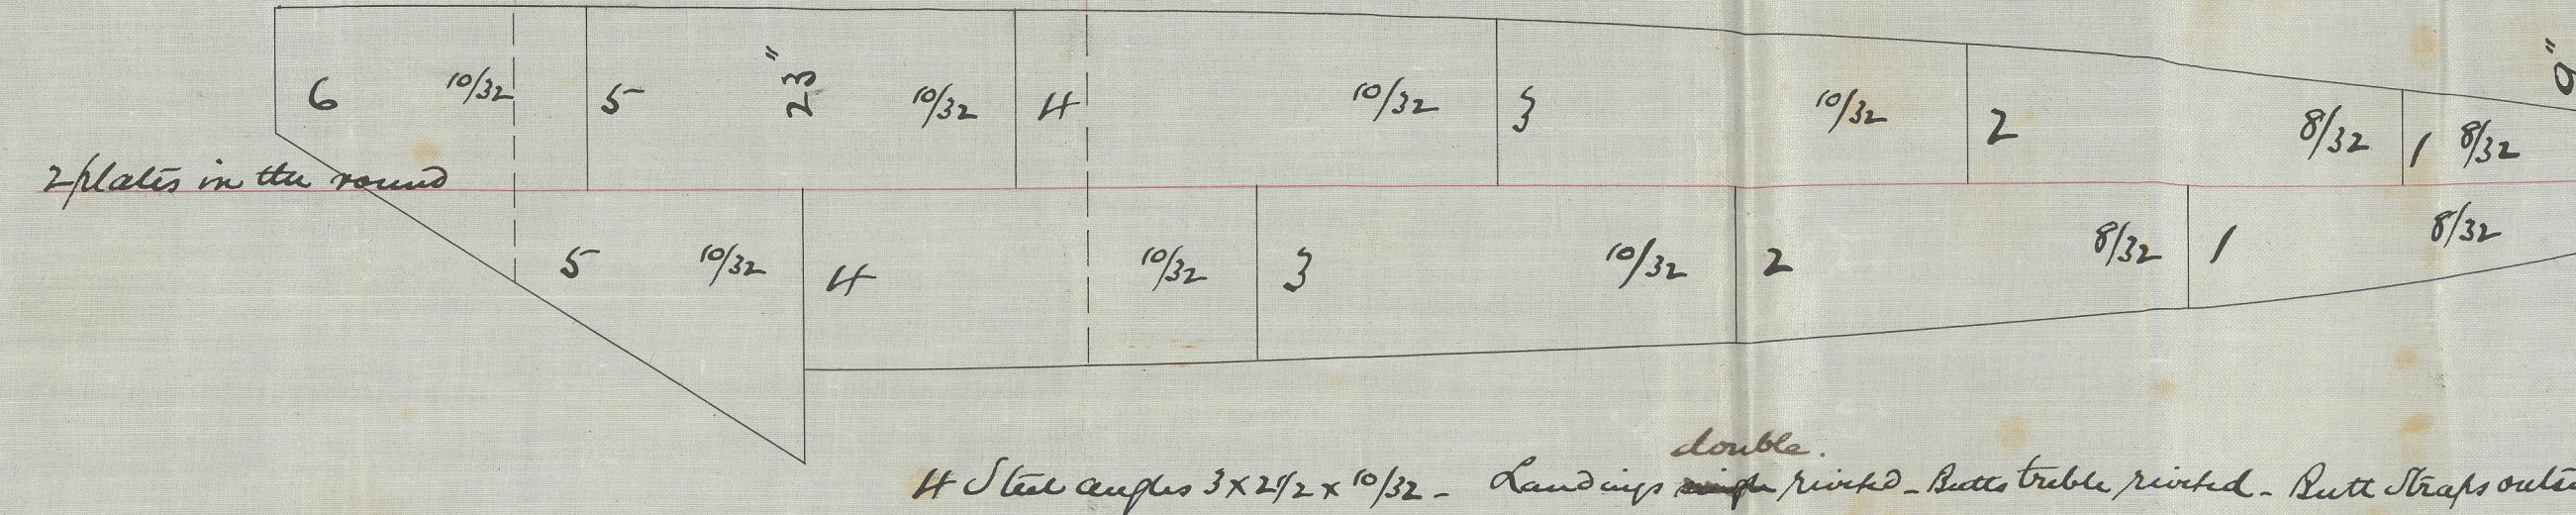


Dr. L. G. G.
14/10/84.
15.1.85.

Steel masts & spars,
of Barque No. 7/Q.


JOHN REID & CO
SHIPBUILDERS,
PORT-GLASGOW.
6th Dec 1884.

Fore & main Topmasts
Fidels to rounds 36'-6"
Head 6-6
Overall 43'-0"

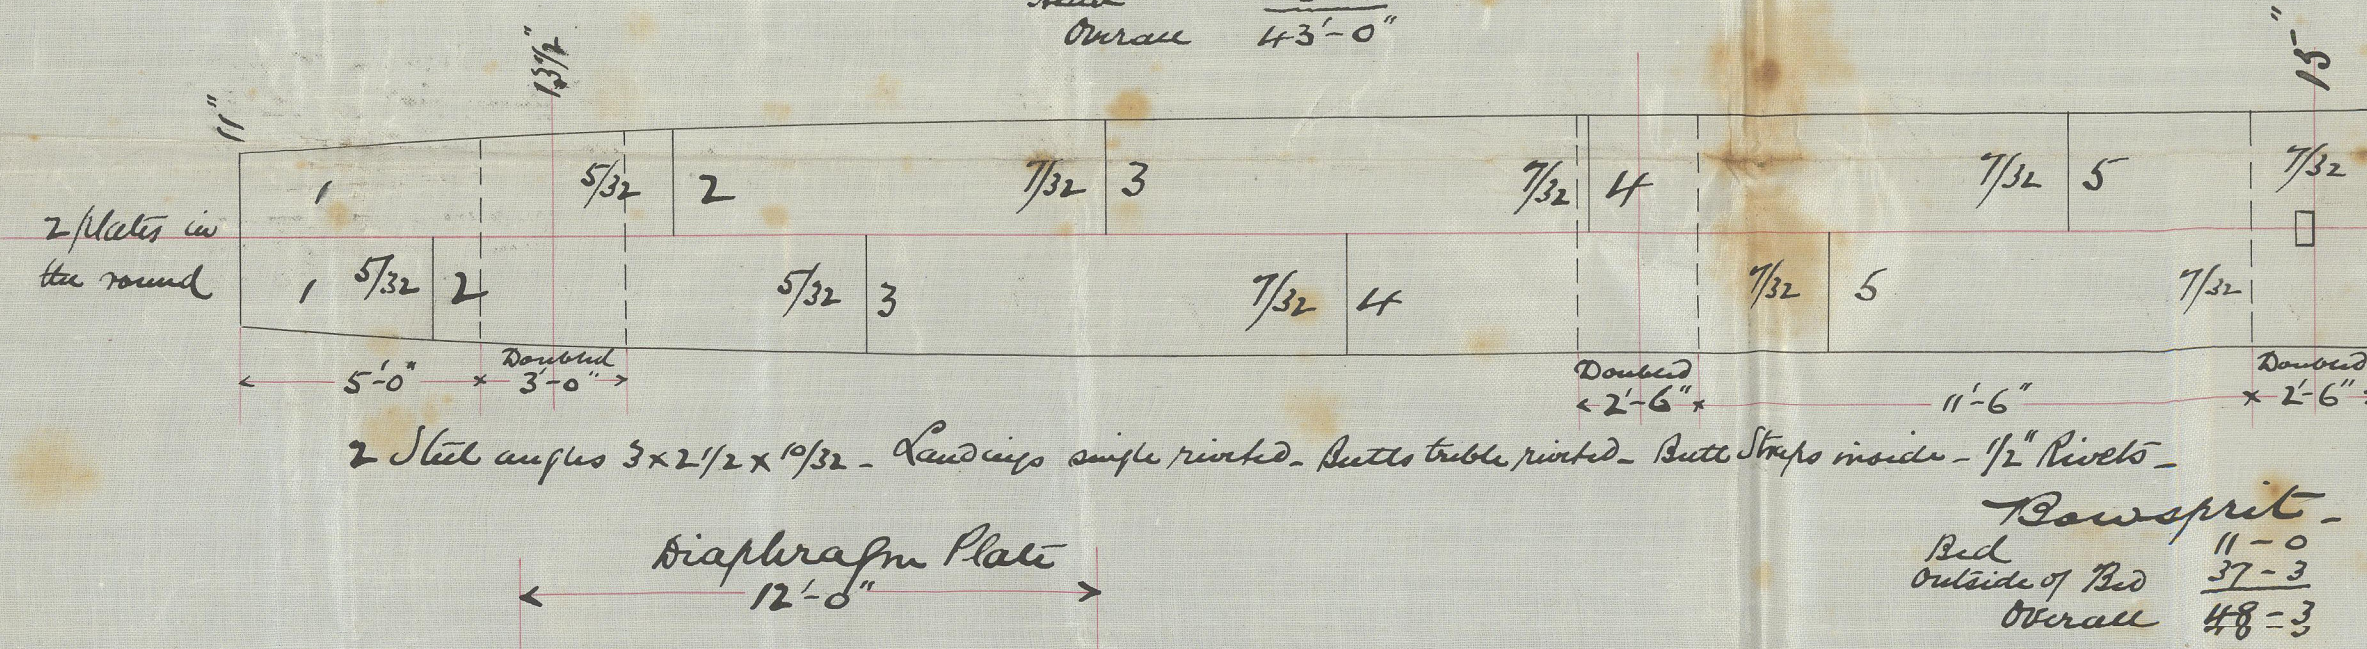


J.R.
14/10/84


Barque John o' Gaunt :
Greenock Report No. 8907

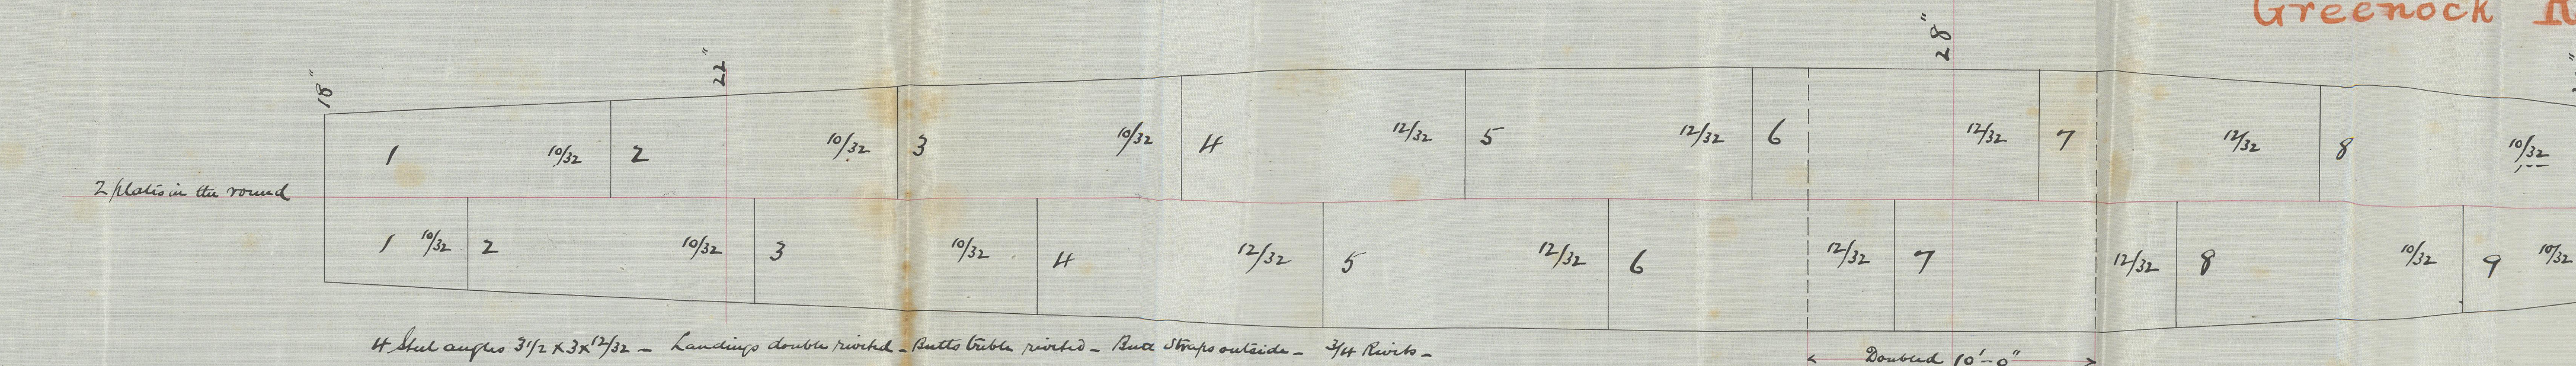


Fore Mast
Fidels to rounds 27'-3"
Head 4'-3"
Overall 31'-6"

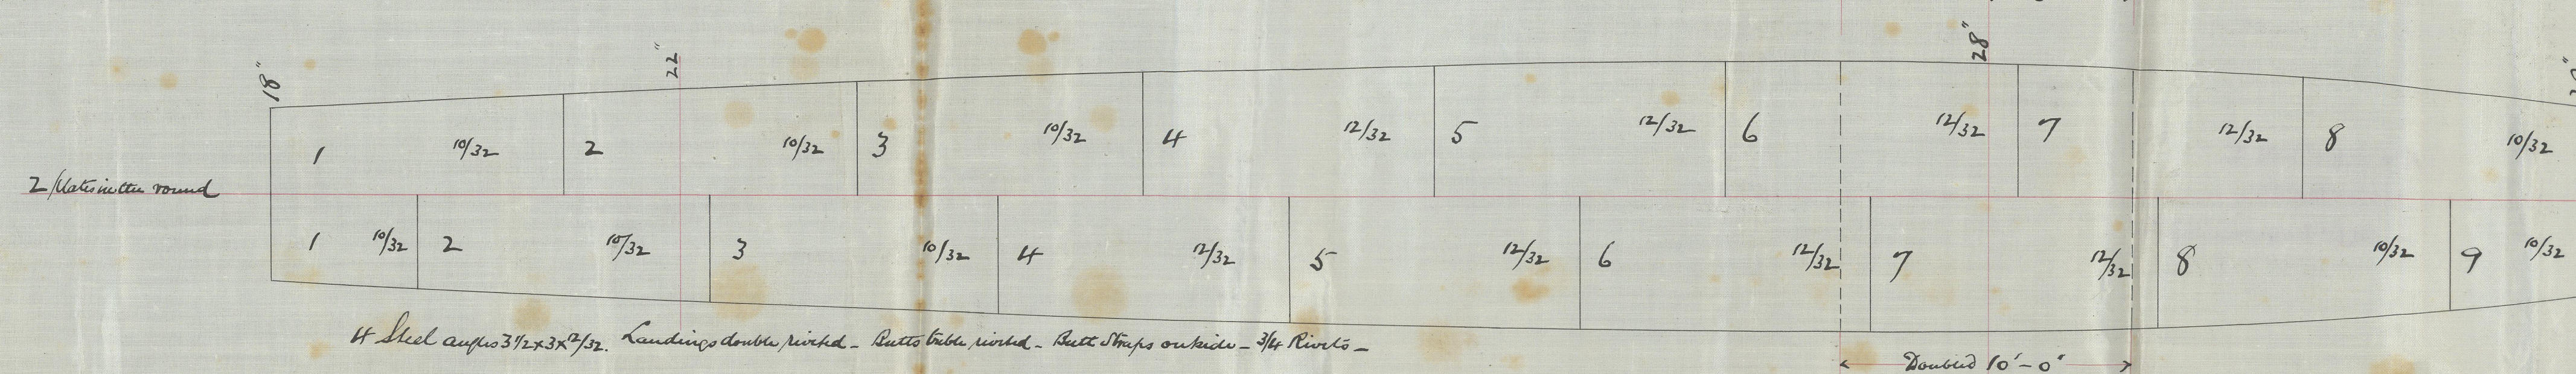


Main Mast
Fidels to rounds 20'-7"
Head 4'-5"
Overall 25'-2"

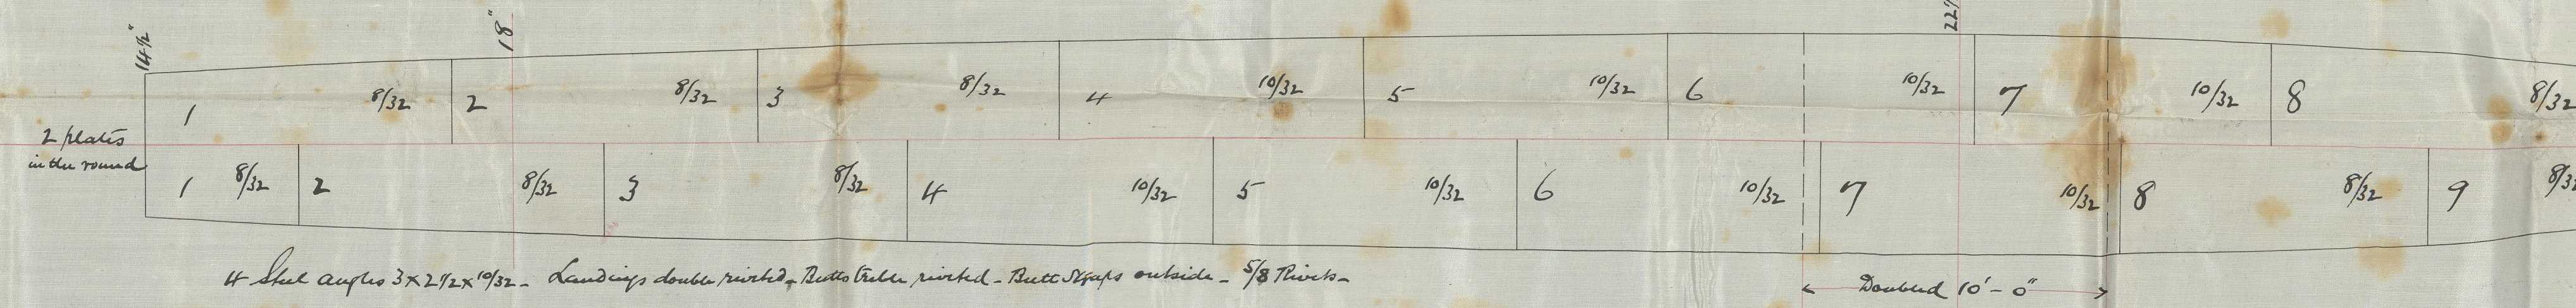

Main Mast
Fidels to rounds 21'-4"
Head 4'-5"
Overall 25'-9"

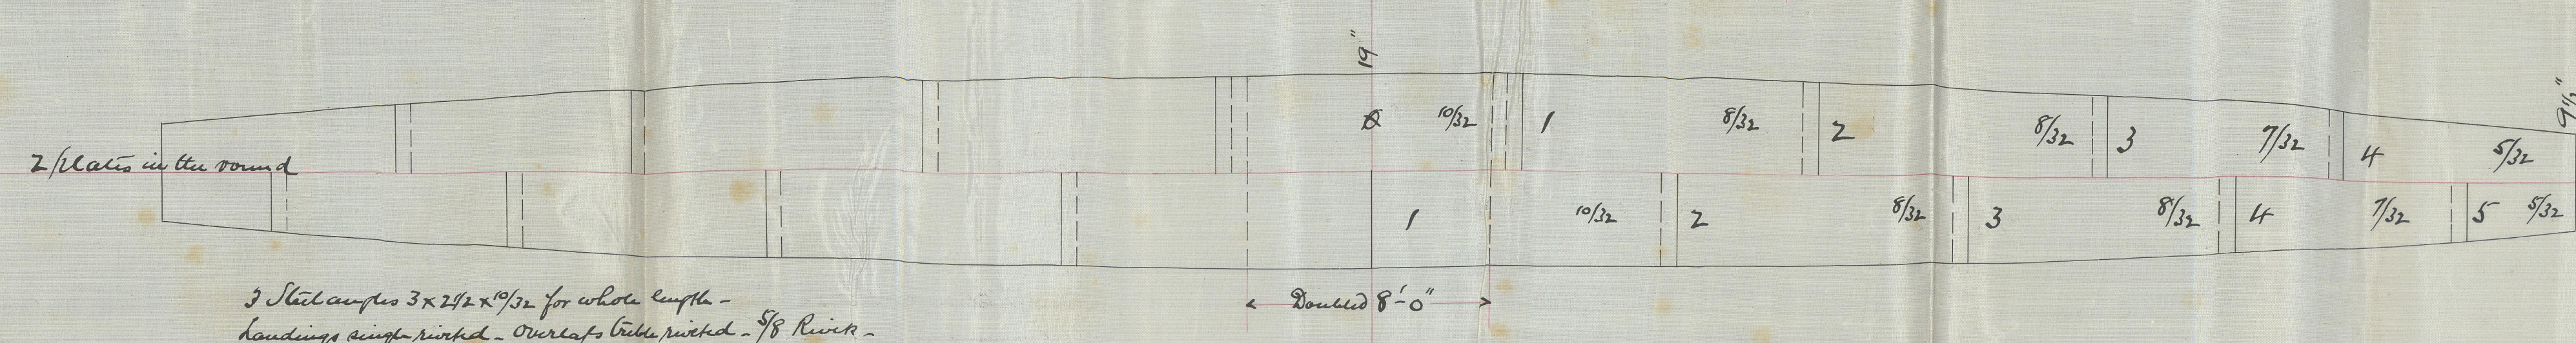

Fore & Main Lower Yard
78'-0"

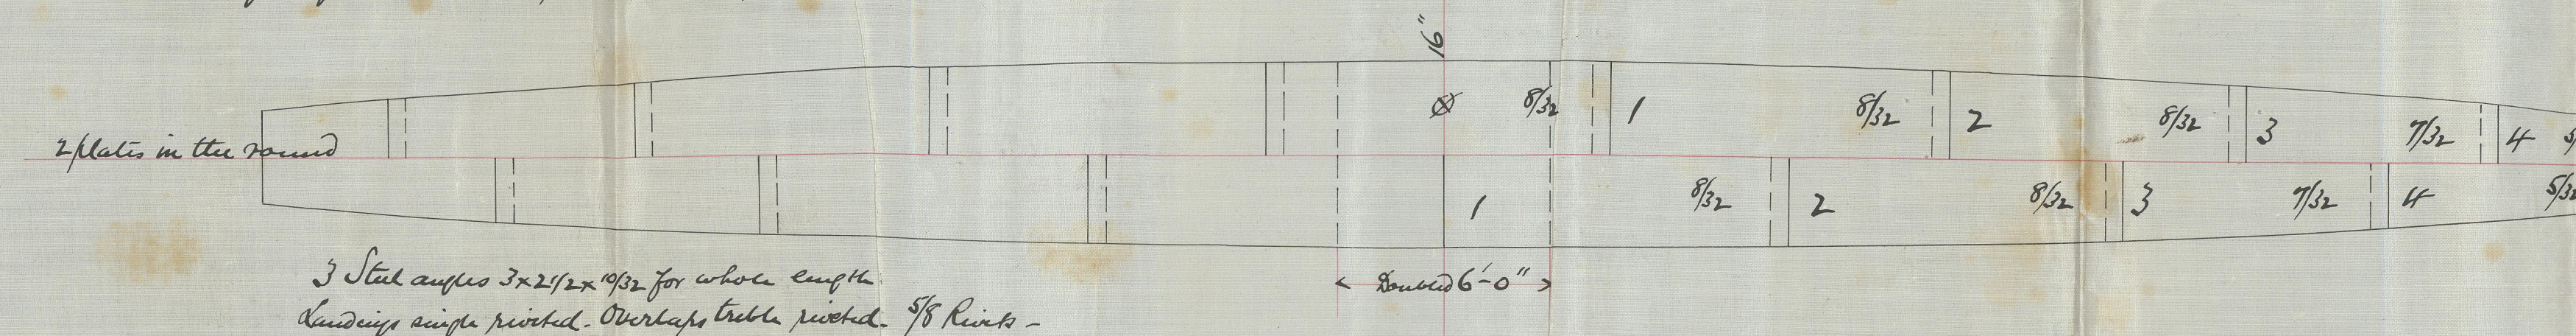

Fore & Main Lower Topmast Yard
67'-0"