


Dr. to Link
28/8/84
15.1.85

Midship Section
of Steel Sailing Barque no. 7/2.
Scale 1/2 Inch = 1 Foot

Lengths in mm etc.

1/2 Girth	36.0	
1/2 Breadth	18.0	
Depth	23.9	
	77.9	Small no.
	23.37	
	77.9	
	155.8	
	16592.7	Large no.

Barque JOHN O' GAUNT
Greenock Report No. 8907

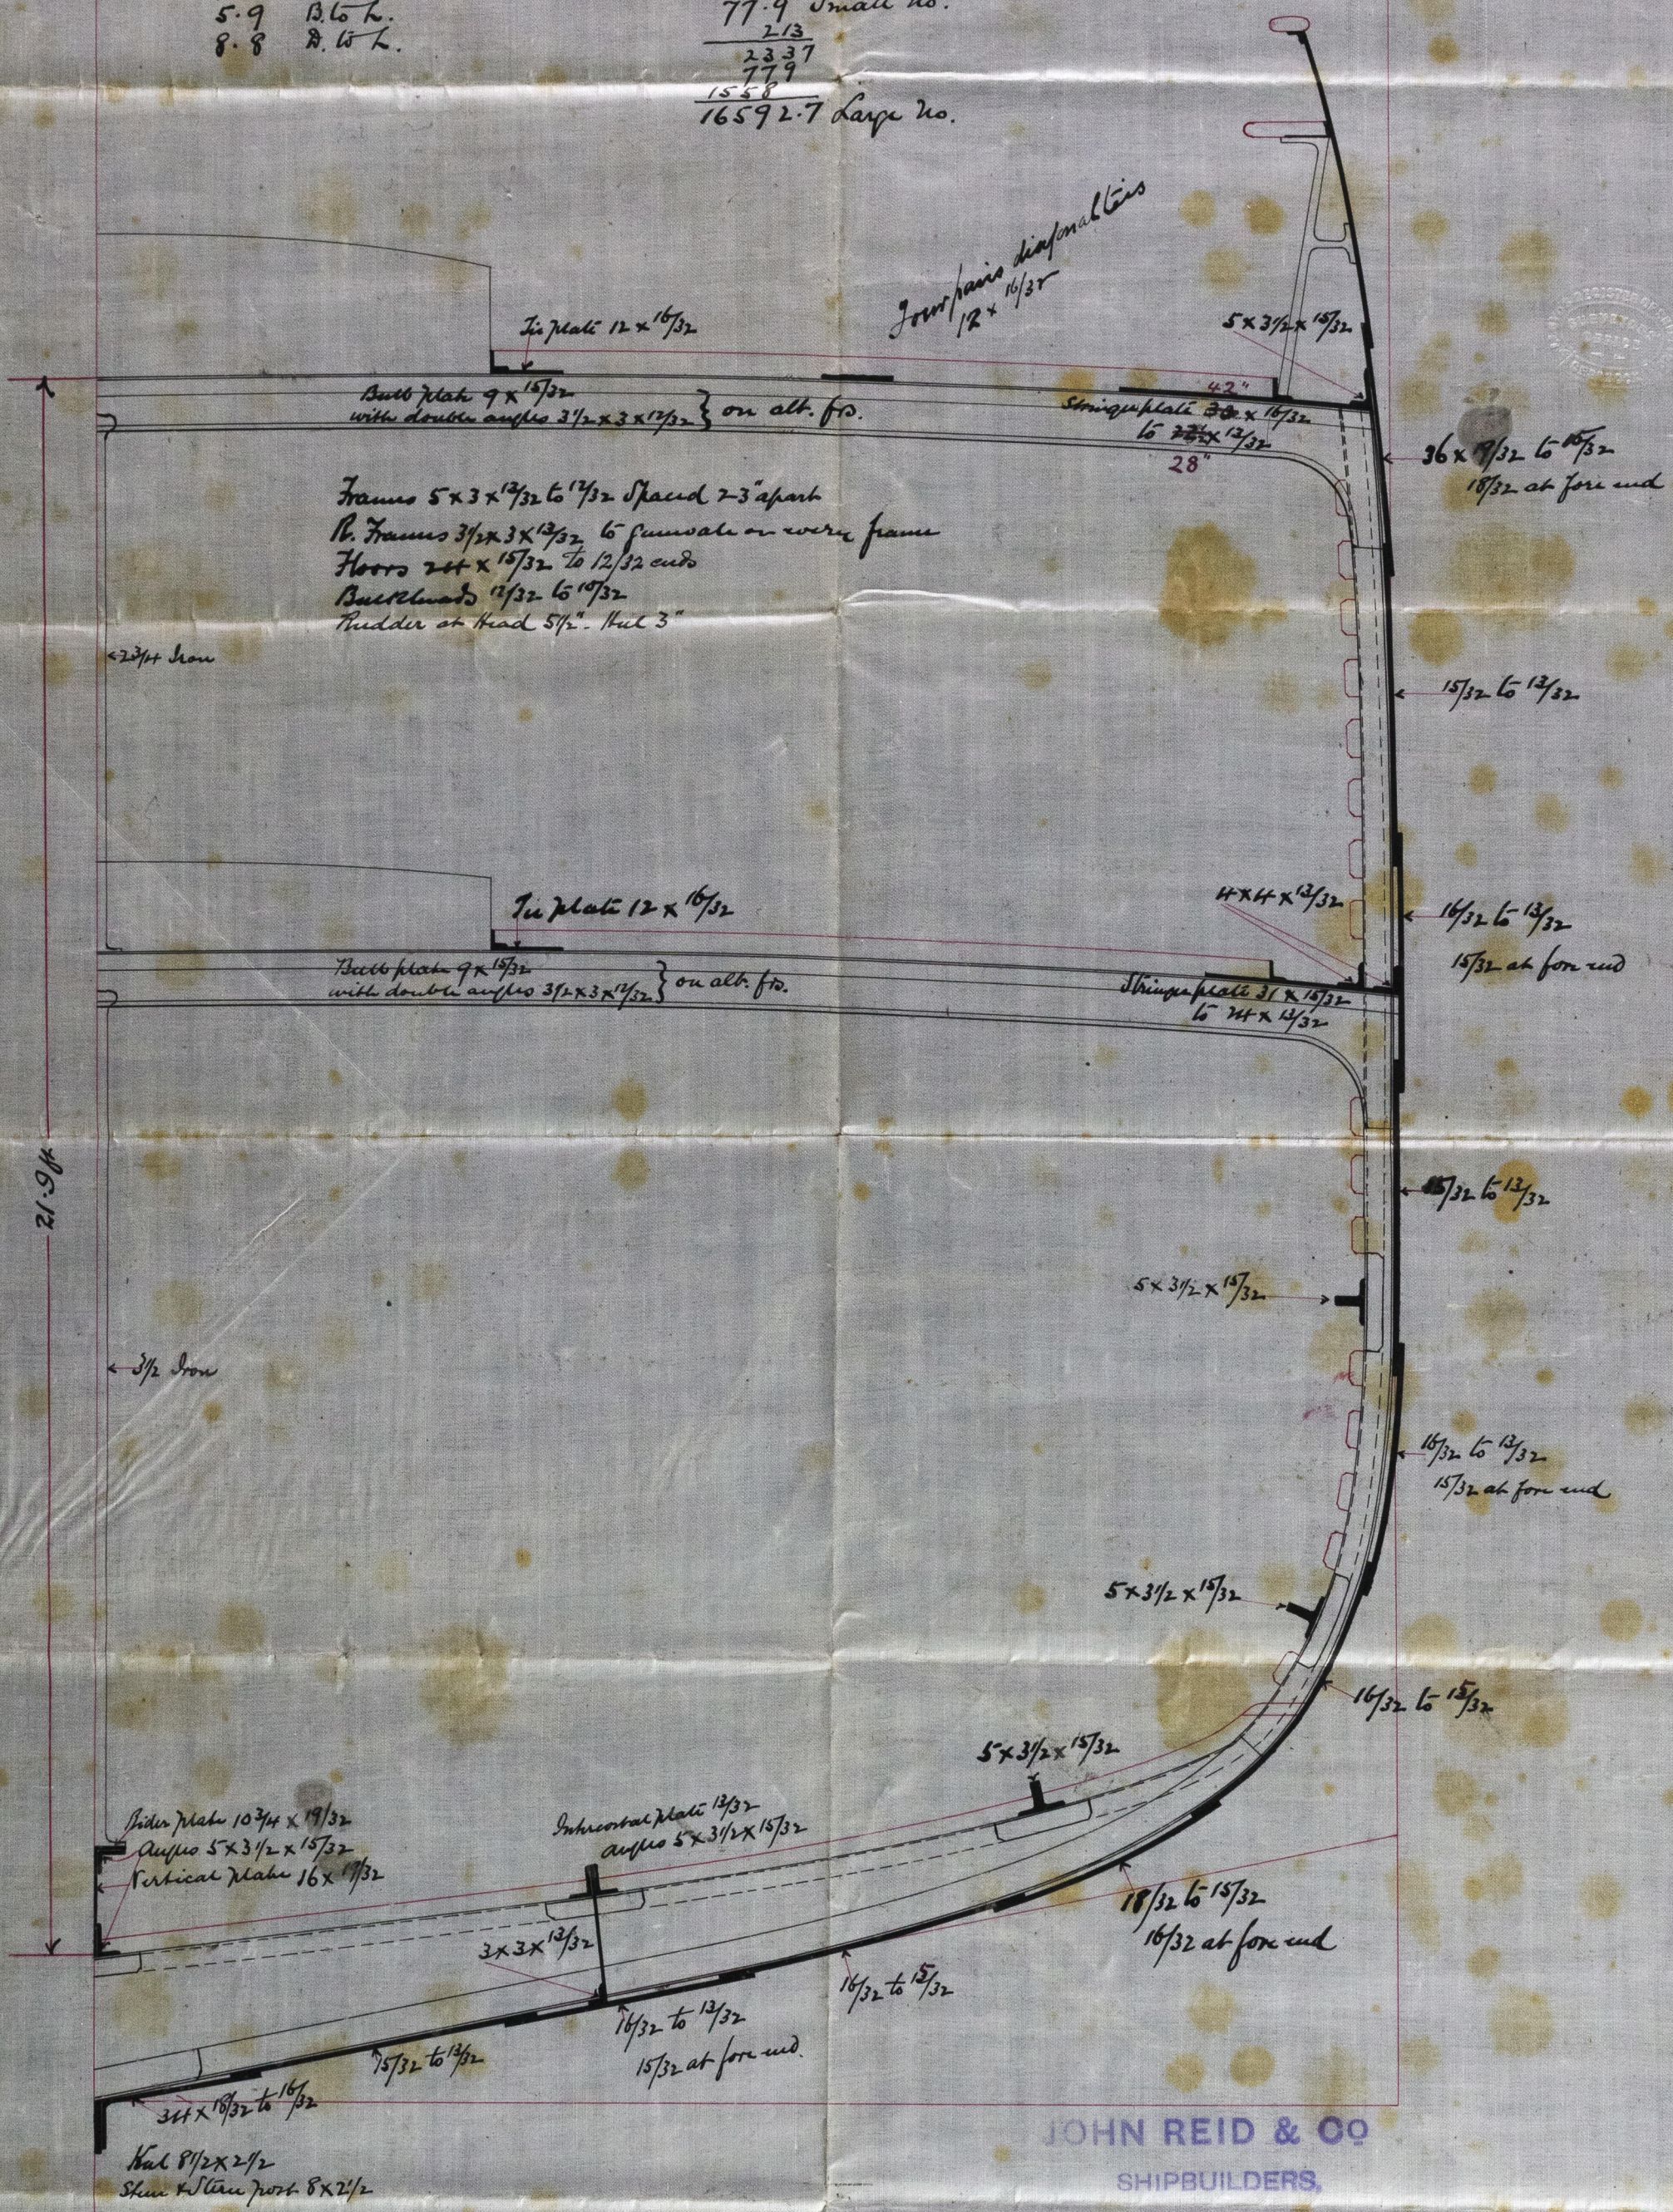

JOHN REID & CO
SHIPBUILDERS,
PORT GLASGOW
20/8/84 MRB.