

Lloyd's Register of British and Foreign Shipping.

(Report on Vessel No. _____ Port _____)

No. 896

SHIP FORGINGS OR CASTINGS.

may be required.

I have to report that the undermentioned Iron ~~or Steel~~ Forgings or Castings, manufactured by
The Lancefield Forge Co of *Glasgow*
 for the Vessel No. *4/Q*, being built by *Messrs John Reid & Co*
 of *Port Glasgow* have been inspected by me as set forth below, and found
 to be, so far as can be seen, *sound and efficient*

Mark on Forgings.

Lloyd's


No. 896

G.N.

*George Newcomb**Port**Glasgow**15/10/84.*

	STERN FRAME.	RUDDER FRAME.	STEM & Keel Bars.
Material* - - - -	<i>Scrap iron</i>	/	<i>Scrap iron</i>
How made - - - -	<i>Forged</i>		<i>Forged</i>
Dimensions - - - -	<i>8 x 2 1/2</i>		<i>8" x 2 1/2</i>
Progress on Inspection -	<i>Forged & smithed</i>		<i>Forging & completed</i>
Dates when Inspected {	<i>14.19.22.30/9/84.</i>		<i>2.9.13.15.19/8/84.</i>

SKETCHES OF FRAMES SHEWING POSITION AND DESCRIPTION OF WELDS OF FORGINGS, OR PARTICULARS OF TESTS APPLIED TO CASTINGS.

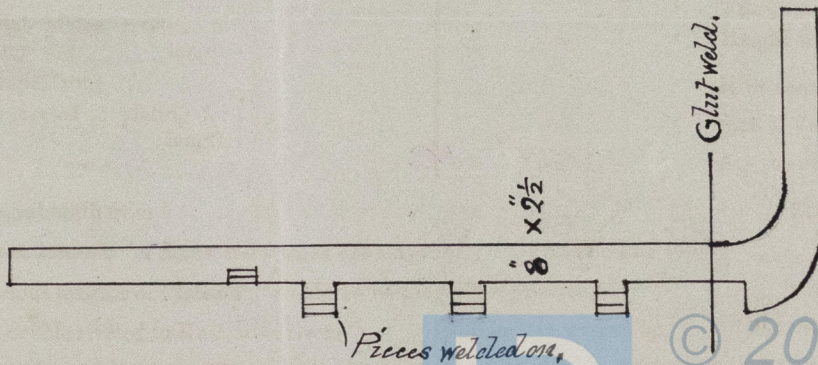

© 2019

Lloyd's Register
Foundation