

Lloyd's Register of British and Foreign Shipping.

(Report on Vessel No. _____ Port _____)

No. 171.A.

SHIP FORGINGS OR CASTINGS.

I have to report that the undermentioned Iron or Steel Forgings or Castings, manufactured by

Messrs R S Bagnall & Son of *Hoylton*
 for the Vessel No. *124*, being built by *Messrs Russell & Co.*
 of *Grainorm* have been inspected by me as set forth below, and found
 to be, so far as can be seen, *sound and efficient.*

The words FORGINGS or CASTINGS, IRON or STEEL, should be struck-out as may be required.

Mark on Forgings.


Lloyd's
 No. 171.A.
R & Co.

H Cameron.

Sunderland.

	STERN FRAME.	RUDDER FRAME.	STEM.
Material*	<i>Scrap Iron</i>	<i>Scrap Iron</i>	<i>Scrap Iron</i>
How made	<i>Forged</i>	<i>Forged</i>	<i>Forged</i>
Dimensions	<i>8 1/2" x 2 1/2"</i>	<i>6'-3"</i>	<i>8 1/2" x 2 1/2"</i>
Progress on Inspection	<i>Forged Smithed</i>	<i>Forged Smithed</i>	<i>Forged</i>
Dates when Inspected	<i>Oct 28 - Nov 4 - 11 - 14 / 84</i>	<i>Dec 3 - 6 - 10 - 12 - 17 - 22 - 31 / 84</i> <i>July 17 July 11 - 21 - 24 / 85</i>	<i>Oct 21 - Nov 4 / 84</i>

SKETCHES OF FRAMES SHEWING POSITION AND DESCRIPTION OF WELDS OF FORGINGS, OR PARTICULARS OF TESTS APPLIED TO CASTINGS.

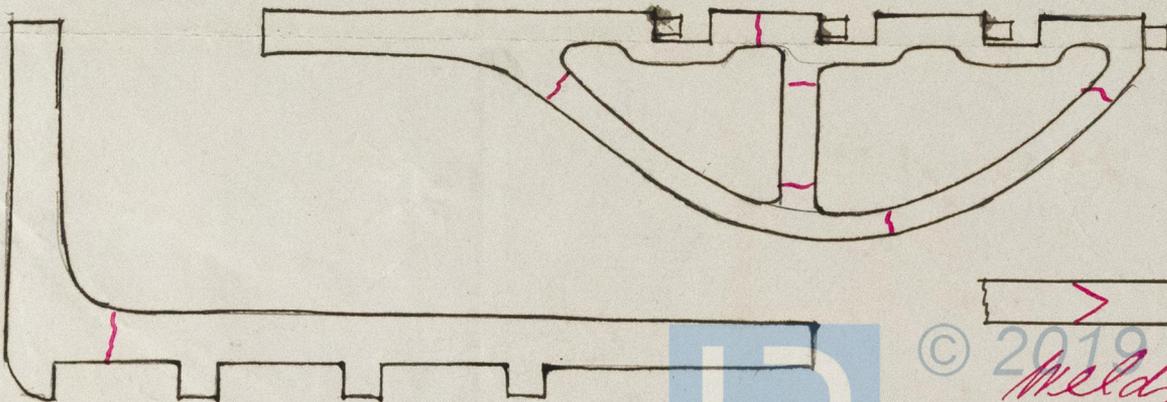

© 2019
Melds

Lloyd's Register
 Foundation