

SCALE $\frac{1}{2}$ " INCH-ONE FOOT.

Classed 100 A.1.

ship Soudan:

Greenock Report No. 8920

Reg^d Dimensions 250' x 38' 2" x 23'-0"

 $\frac{1}{2}$ Girth = 39.70

1/2 Breadth 18.99

Depth = 25.25

83' 94 = 1st Numeral

238.25 = Length


19998.7 ✓ = 2nd π Numeral

$$\frac{1.3332}{213319} = \frac{15 \text{ added for Poap.}}{\text{Compensation}}$$

27551 ✓ = Equipment

Equipment.

1	Bower Anchor	excluding Stock	3 1/2	Cwts
1	"	"	32 1/2	"
1	"	"	30 1/2	"
1	Stream	"	10 3/4	"
1	Kedge	"	5 1/2	"
1	"	"	2 1/2	"
270	Fathoms	1 1/10"	Chain	
75	"	1"	Stream Chain	
90	"	11"	Tow Line	
90	"	10"	Bawlers	
90	"	6"	Traps	

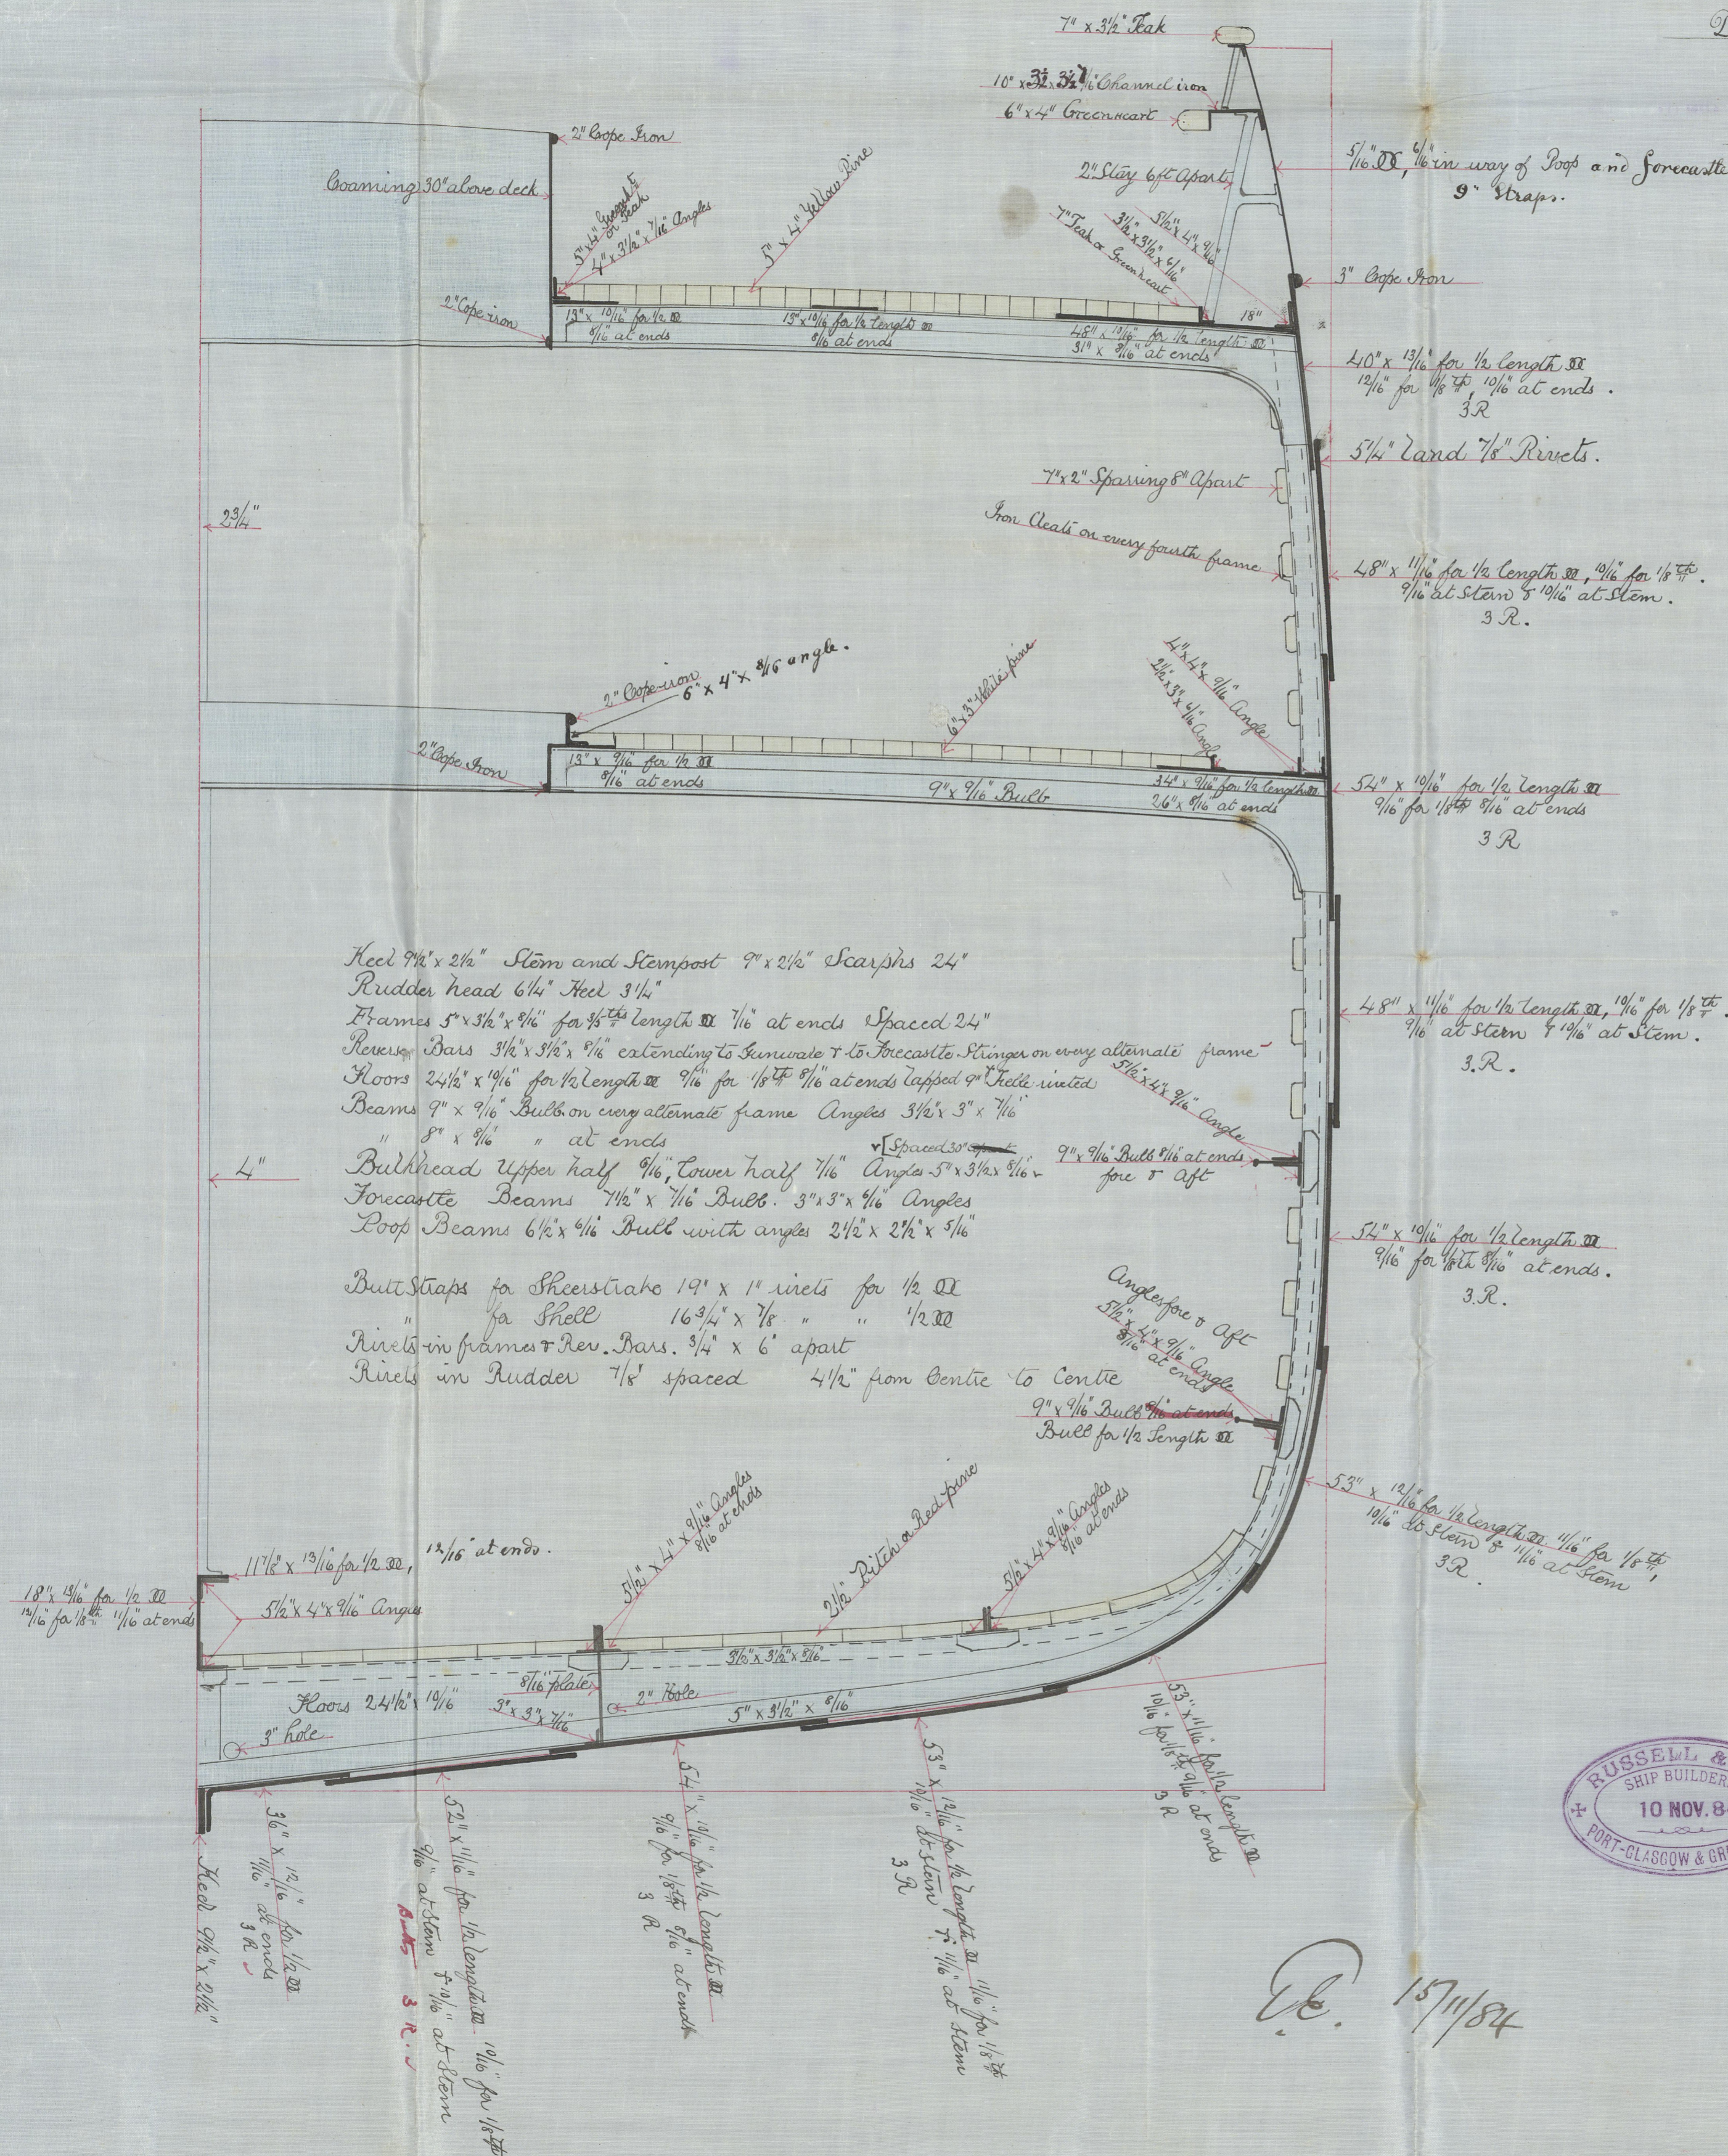

P.C. 15711/84