

Lloyd's Register of British and Foreign Shipping.

(Report on Vessel No. _____ Port _____)

No. 961

SHIP FORGINGS OR CASTINGS.

may be required.

I have to report that the undermentioned Iron or Steel Forgings or Castings, manufactured by The Lancefield Forge Co of Glasgow for the Vessel No. 124, being built by Messrs Russell & Co of Port Glasgow have been inspected by me as set forth below, and found to be, so far as can be seen, sound and efficient

Mark on Forgings.

Lloyd's

No. 961

G.N.

George Newcomb


Glasgow

14/2/85.

Post

	STERN FRAME.	RUDDER FRAME.	STEM & Keel Bars
Material*	<i>Scrap iron</i>	/	<i>Scrap iron</i>
How made	<i>Forged</i>		<i>Forged</i>
Dimensions	<i>9" x 2 1/2"</i>		<i>9" x 2 1/2"</i>
Progress on Inspection	<i>Completed</i>		<i>Forging & completed</i>
Dates when Inspected	<i>3/2/85.</i>		<i>14.28.31/1/85. 3.10.13/2/85</i>

SKETCHES OF FRAMES SHEWING POSITION AND DESCRIPTION OF WELDS OF FORGINGS, OR PARTICULARS OF TESTS APPLIED TO CASTINGS.

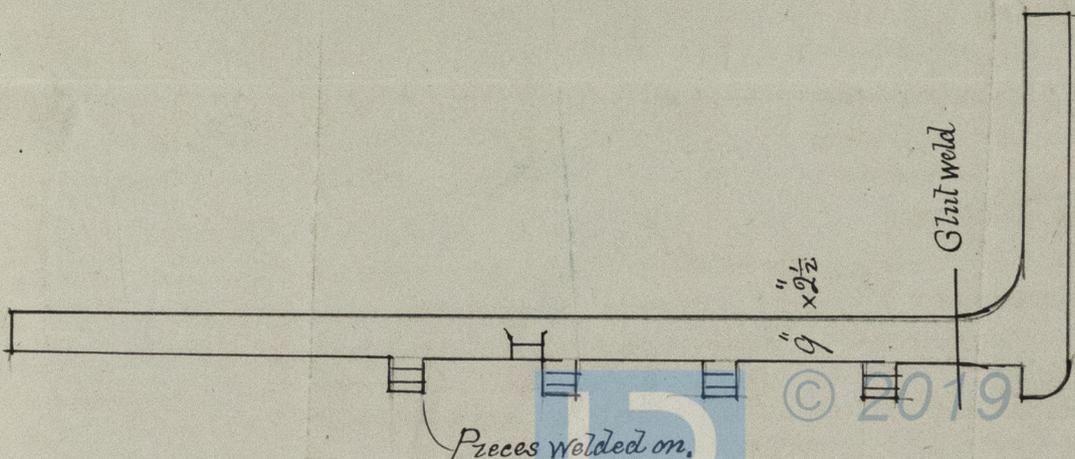

Pieces welded on.

© 2019

Lloyd's Register Foundation

* If of Iron, state whether scrap or puddled Iron.